Instrument H: 2018-0951
05/31/2018 01:06:39 PM Total Pages: 1
SCC SECTION CORNER CERTIFICATES
Recording Fee: \$ 7.00
Cindy Messersmith, Recorder, Chickasaw County Iowa

SHIMAK SURVEYING, P.L.I.C., 3212 335th Stre	et, Cresco, Iowa 52136 Phone (563) 379-8899
UNITED STATES PUBLIC LAND	SURVEY CORNER CERTIFICATE
C)F
and Survey Monuments situated in Section	n <u>26</u> , Township <u>94</u> North, Range
	ridian, Chickasaw County, Iowa.
	90 2.) None in County Recorder's Office.
Show reason for preparing this certificate, the evidence he corner positions and monumentation found or pla	
Monument Description and Remarks: 1,) SW	Corner of Section 26-T94N-R11W:
d. 1/2"ø Rebar. w/Red Plastic Sleeve. The	2"ø Alum. Cap is missing. From Previous
Section Corner Certificate.	
One Tie is missing. Ties were Placed as Sh	
2.) W 1/4 Corner of Section 26-T94N-R11W:	
Fd. 1/2" Sqr. Twst. Iron Bar from County I	
One Tie is missing. Ties were Placed as Sh	own Below.
PLAN -	- VIEW
Ref. Set 1/2** Rebor (No Cap) Ref. Fd. 1/2** Rebor (No Cap) Ref. Fd. 1/2** Rebor (No Cap) Ref. Fd. 1/2** Rebor (No Cap) Ref. Fd. 1/2** Rebor (No Cap) Ref. Fd. 1/2** Rebor (No Cap) Ref. Fd. 1/2** Rebor (No Cap) Ref. Fd. 1/2** Rebor (No Cap) Ref. Fd. 1/2** Rebor (No Cap) Ref. Fd. 1/2** Rebor (No Cap) Ref. Fd. 1/2** Rebor (No Cap) Ref. Fd. 1/2** Rebor (No Cap) Ref. Fd. 1/2** Rebor (No Cap) Ref. Fd. 1/2** Rebor (No Cap) Ref. Fd. 1/2** Rebor (No Cap) Ref. Fd. 1/2** Rebor (No Cap) Ref. Fd. 1/2** Rebor (No Cap) Ref. Fd. 1/2** Ref	Ref. Fd. 1/2" Ref. Fd. 1/2" Sgr. Twst. Iron Bor Damaged-Reset Field Drv. Field Drv.
1.) SW Corner of Section 26-T94N-R11W Fd. 1/2"ø Rebar (No Cap)	2.) W 1/4 Corner of Section 26—T94N—R11W Fd. 1/2" Sqr. Twst. Iron Bar
hereby certify that this land surveying docum	List Corners to be Indexed



I hereby certify that this land surveying documer was prepared and the related survey work was performed by me or under my direct personal supervision and that I am a duty licensed Land Surveyor under the laws of the State of lowa.


Michael J. Shimak Date:

License number 16961 My license renewal date is December 31, 2019. Sheets covered by this seal: Sheet P1

Lis Corners	t Corners Section	to be Indexed Twp.	Range
1.) SW Corner	26	94N	11W
2.) W 1/4 Corn	er 26	94N	1 1W

Project Number: 18-07-18,LS FB. Howard/Chickesaw No. 1, Pgs. 5-10

Chickasaw Co. Recorder Cindy Messersmith Fee Book 2010-1490 10/01/2010 60421PM SEC COR CERT Book; Page: \$9.00 # Pages: 1

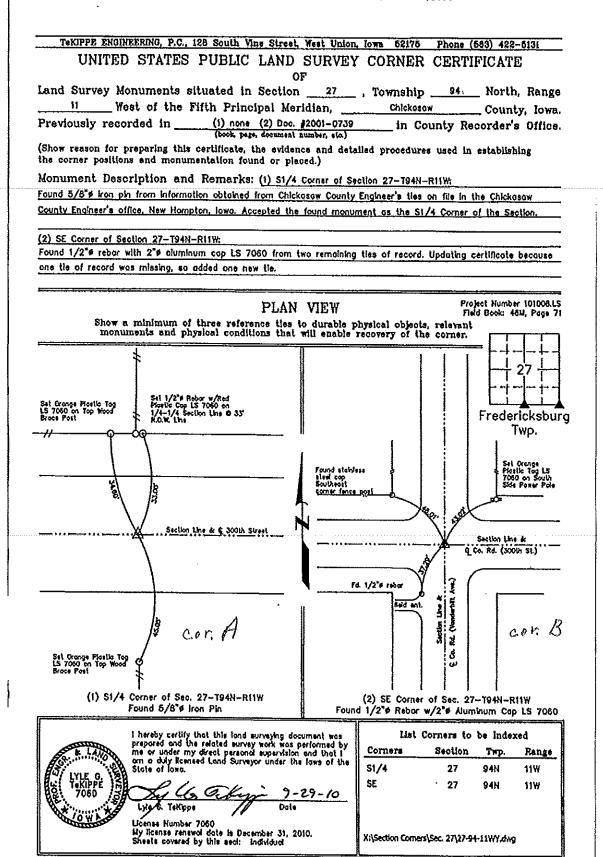

Section 27-94-11
As referred to in
Engl. The Book

Tekippe Engineering, P.C., 128 South Vine Street, West Union, Iowa 52175 Phone (319) 422-5131
UNITED STATES PUBLIC LAND SURVEY CORNER CERTIFICATE
of 2.7
Land Survey Monuments situated in Section26 , Township94 North, Range
11 West of the Fifth Principal Meridian, CHICKASAW County, Iowa.
Previously recorded in none in County Recorder's Office.
(Show reason for preparing this certificate, the evidence and detailed procedures used in establishing the corner positions and monumentation found or placed.)
Monument Description and Remarks: SW Corner Section 26 T94N RilW: Set 1/2" o rebar
w/2" ø aluminum cap LS 7060 with Chickasaw County ties obtained from the Chickasaw
County Engineer's Office in the Field Book Fredericksburg Township, Corner B, Section
27. Two reference ties were missing. One reference tie was added.
DI ANI WILLIAM Project Number 01045.IS
FR. 481 FG. 18-19
(Show a minimum of three reference ties to durable physical objects, relevant monuments and physical conditions that will enable recovery of the corner.)
Sec. 26
Ri1W Ri1W
Found stainless Steel cap Southwest Fredericksburg Two
steel cap Southeast quadrant of
corner fence post power pole
16.00
10/3 K33.30
Section Line &
Ç Co Rd. (300th St.)
<i>Sli</i>
Set 1/2"ø rebar
Set 1/2"ø rebar se su light se
Set 1/2" o rebar % Section Field ent.
22-94-11 Solici
·
W

SW Corner Section 26 T94N R11W Set 1/2"ø rebar w/2"ø aluminum cap LS 7060



I hereby certify that this land surveying document was prepared and the related survey work was performed by me or under my direct personal supervision and that I am a duly licensed land Surveyor under the laws of the State of Iowa.

Lyle G. TeKippe Date

My license renewal date is December 31, 2002. Sheets covered by this seal: Individual

Corners	List Corners Section	to be Indexed Twp.	Range
sw	26	94N	11W

Filed