

Prepared By: Andrew J. Smith, Veenstra & Kimm, Inc. 2800 Fourth St. SW, Mason City, Iowa (561) 421-8008

UNITED STATES PUBLIC LAND SURVEY CORNER CERTIFICATE


35 OF

Land Survey Monuments situated in Section 36, Township 94N, Range 11W, of the Fifth Principal Meridian,
 Chickasaw County, Iowa. Previously recorded in Doc. # N/A In County Recorder's Office.

Monument Description and Remarks: Center Corner: No monument and no corner tie certificate on file. Set 1/2" iron rod with YPC at intersection of lines from N 1/4 Corner to S 1/4 and from West 1/4 Corner to East 1/4 Corner. Corner fell in 10' +/- wide grass fence line but 3' east of remnants of partial north/south fence line.
SE Corner of NE 1/4 NW 1/4: No monument and no corner tie certificate on file. Set 1/2" iron rod with YPC midway between N 1/4 Corner and Center Corner. Corner fell in 10' +/- wide grass fence line but 3' east of remnants of partial north/south fence line. Corner fell in line with partial remnants of east/west fence line.
SW Corner of NW 1/4 NW 1/4: No monument and no corner tie certificate on file. Set 1/2" iron rod with YPC midway between NW Corner and W 1/4 Corner.

PLAN - VIEW

(Show a minimum of three reference ties to durable physical conditions that will enable recovery of the corner.)

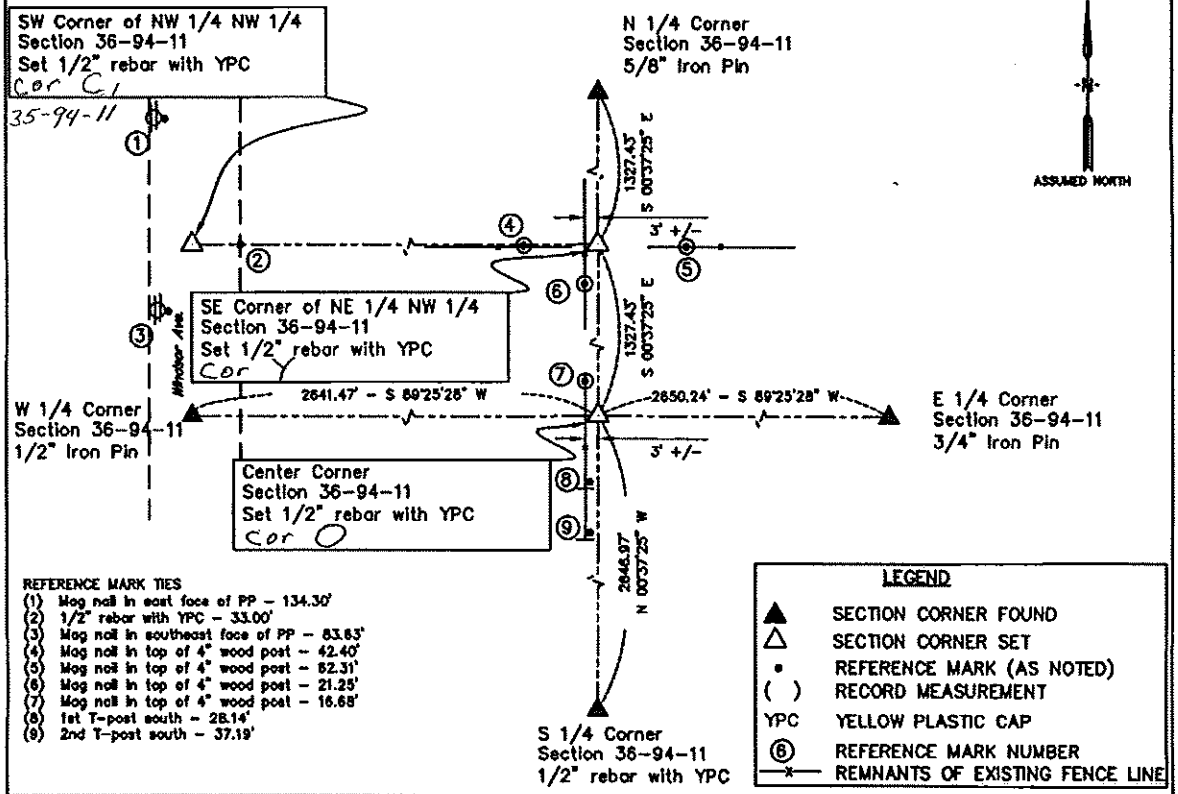


I hereby certify that this Land Surveying document was prepared and the related survey work was performed by me or under my direct personal supervision and that I am a duly licensed Land Surveyor under the laws of the State of Iowa.

Andrew J. Smith 6/14/11
 Andrew J. Smith Date

License Number 14233
 My license renewal date is December 31, 2011

V&K
VEENSTRA & KIMM, INC.
 PROJECT NO: Cohoy - 36-94-11
 SHEET 1 OF 1

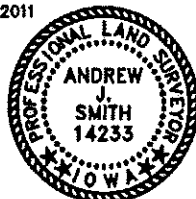

LAND CORNER TO BE INDEXED

Corners	Sections	Twp	Range
Center	36	94N	11W
SE of NE 1/4 NW 1/4	36	94N	11W
SW of NW 1/4 NW 1/4	36	94N	11W

