

Shirley H. Sydnor, Recorder, Shreveport, Louisiana

United States Public Land Survey Corner Certificate


This certificate is being prepared in compliance with Iowa Code Chapter 355.11 because:

- ☐ There is no certificate on file for this corner.
☒ There are no longer three valid ties of record.
☐ There are changes to reference ties of record.
☐ There is change of monumentation of record.
☐ To clarify description of record monument (ties).

S 1/4 Corner:

Found 1/2"Ø Rebar w/Aluminum Cap PLS 7060 with information obtained from the previously recorded Section Corner Certificate.

(Show a minimum of three reference ties to durable physical objects, relevant monuments and physical conditions that will enable recovery of the corner.)

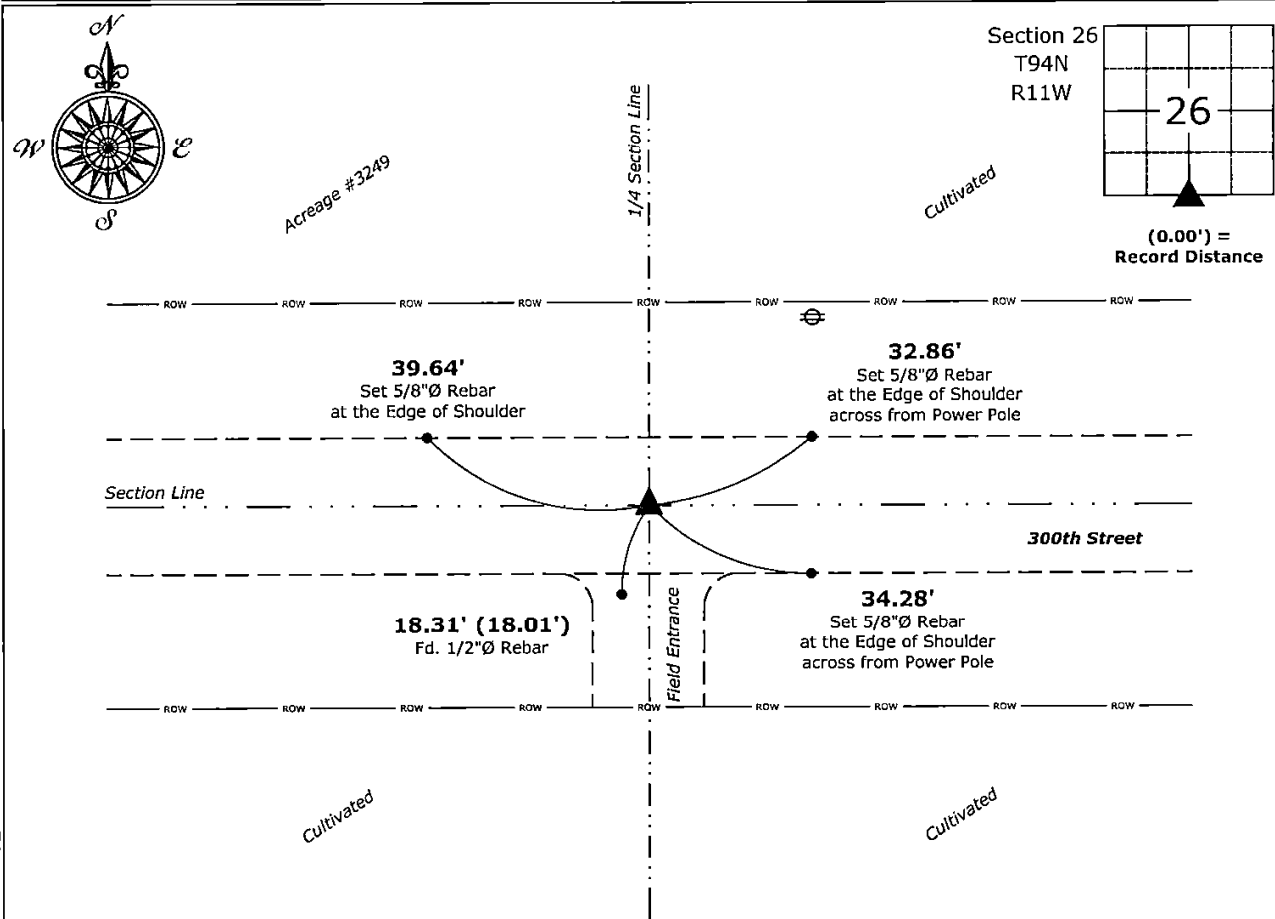

A circular seal for a Professional Land Surveyor in Iowa. The outer ring contains the text "PROFESSIONAL LAND SURVEYOR" at the top and "IOWA" at the bottom, separated by three stars. The center of the seal contains the text "KIRK D. REICKS" and the number "19211".

Keith D. Paul 6-17-2026

List Corner to be Indexed			
Corner	Section	Township	Range
S 1/4	26	94	11

Project Number: 2026-062

FB: Chickasaw 14, Page(s) 53-54

File: S:\ Projects - NHO\County Control Systems\CHICKASAW\CHICK-52\CHICK-52-2026.dwg, 6/17/2026 10:06:28 AM