

Chickasaw Co. Recorder  
 Cindy Messersmith  
**Fee Book 2016-1635**  
 11/30/2016 @01:21PM  
 SCC SEC COR CERT # Pages: 1  
 Total Fees: \$7.00

*Prepared by & Return to Harold - Reicks Surveying, 10 East Main Street, New Hampton, IA 50659, Ph. 641-394-2725*

**United States Public Land Survey Corner Certificate**

Land Survey Monument situated in  
 Section 36, Township 94 North, Range 11 West of the Fifth Principal Meridian, Chickasaw County, Iowa.  
 Not on file in the County Recorder's office.

This certificate is being prepared in compliance with Iowa Code Chapter 355.11 because:

- There is no certificate on file for this corner.
- There are no longer three valid ties of record.
- There are changes to reference ties of record.
- There is change of monumentation of record.
- To clarify description of record monument (ties).


**Monument Description and Remarks:**

**Northwest Corner SE 1/4-SW 1/4:** Set 5/8"Ø rebar w/2"Ø aluminum cap PLS 19211 at the intersection of 1/4-1/4 Section Lines. Buried 18" deep in cultivated field.

An extensive search of all of the records within the County offices was performed as part of the section corner recovery, No records were located of the perpetuation of a monument at this corner.

**Plan View**

(Show a minimum of three reference ties to durable physical objects, relevant monuments and physical conditions that will enable recovery of the corner.)

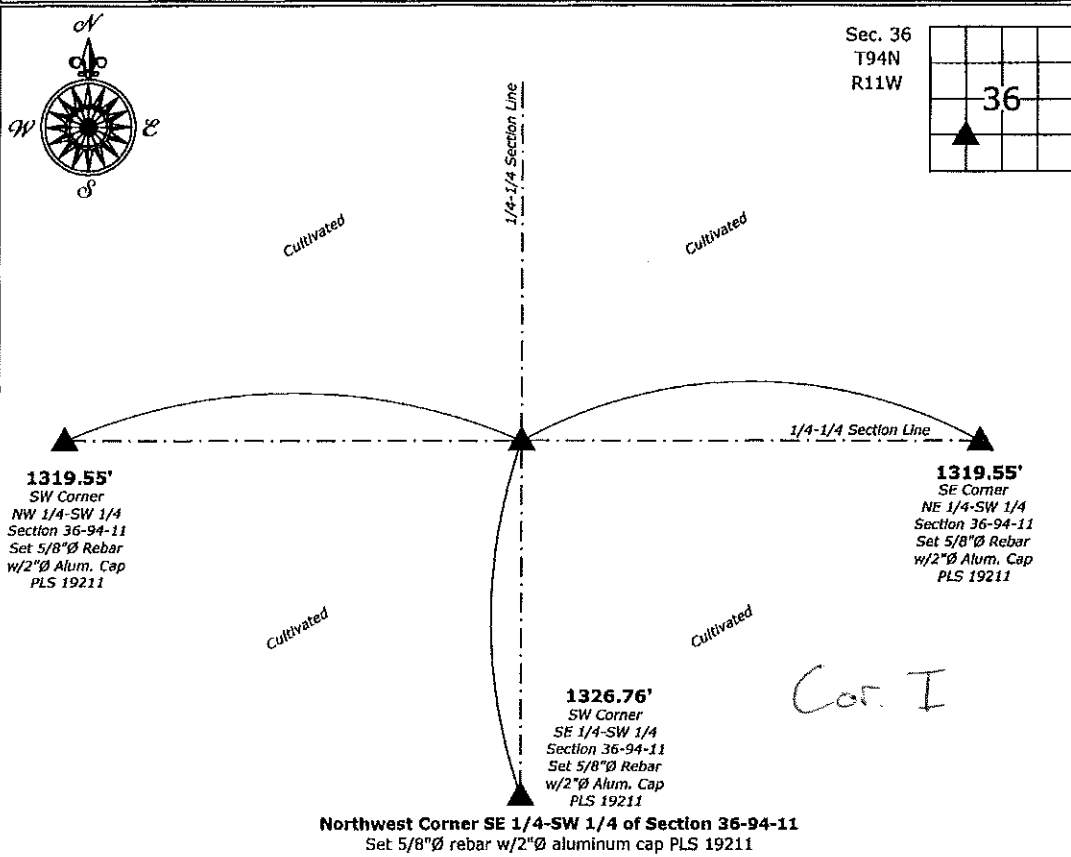

I hereby certify that this land surveying document was prepared and the related survey work was performed by me or under my direct personal supervision and that I am a duly licensed Land Surveyor under the laws of the State of Iowa.

*Kirk D. Reicks 11-30-16*  
 Kirk D. Reicks Date:  
 License number 19211  
 My license renewal date is December 31, 2016.  
 Sheets covered by this seal: Individual sheet only

| List Corner to be Indexed       |         |      |       |
|---------------------------------|---------|------|-------|
| Corner                          | Section | Twp. | Range |
| NW-SE-SW                        | 36      | 94   | 11    |
| Project Number: 2016-118        |         |      |       |
| FB: Chickasaw Co. 7, Pgs. 78-79 |         |      |       |

File: S:\\_CSD Projects\County Control Systems\CHICKASAW\CHICK-52.dwg, 11/22/2016 5:14:47 PM