

Prepared by & Return to: Kirk D. Reicks, HRS, LLC, 10 East Main Street, New Hampton, IA 50659, Phone 641-394-2725

United States Public Land Survey Corner Certificate

Land Survey Monument situated in
Section 33, Township 95 North, Range 11 West of the Fifth Principal Meridian, Chickasaw County, Iowa.
On file in Document #2004-1352 in the County Recorder's Office.

This certificate is being prepared in compliance with Iowa Code Chapter 355.11 because:

- ☐ There is no certificate on file for this corner.
- ☐ There are no longer three valid ties of record.
- ☒ There are changes to reference ties of record.
- ☒ There is change of monumentation of record.
- ☐ To clarify description of record monument (ties).


Monument Description and Remarks:

Southeast Corner:

Found PK Nail 2" deep in asphalt surface with information obtained from the previously recorded Section Corner Certificate. Monument was unstable, therefore removed PK Nail and set 5/8"Ø Rebar w/2"Ø Aluminum Cap PLS 19211 2" deep in asphalt surface. Corner was perpetuated at the request of the Chickasaw County Engineer's Office.

Plan View - Not to Scale

(Show a minimum of three reference ties to durable physical objects, relevant monuments and physical conditions that will enable recovery of the corner.)

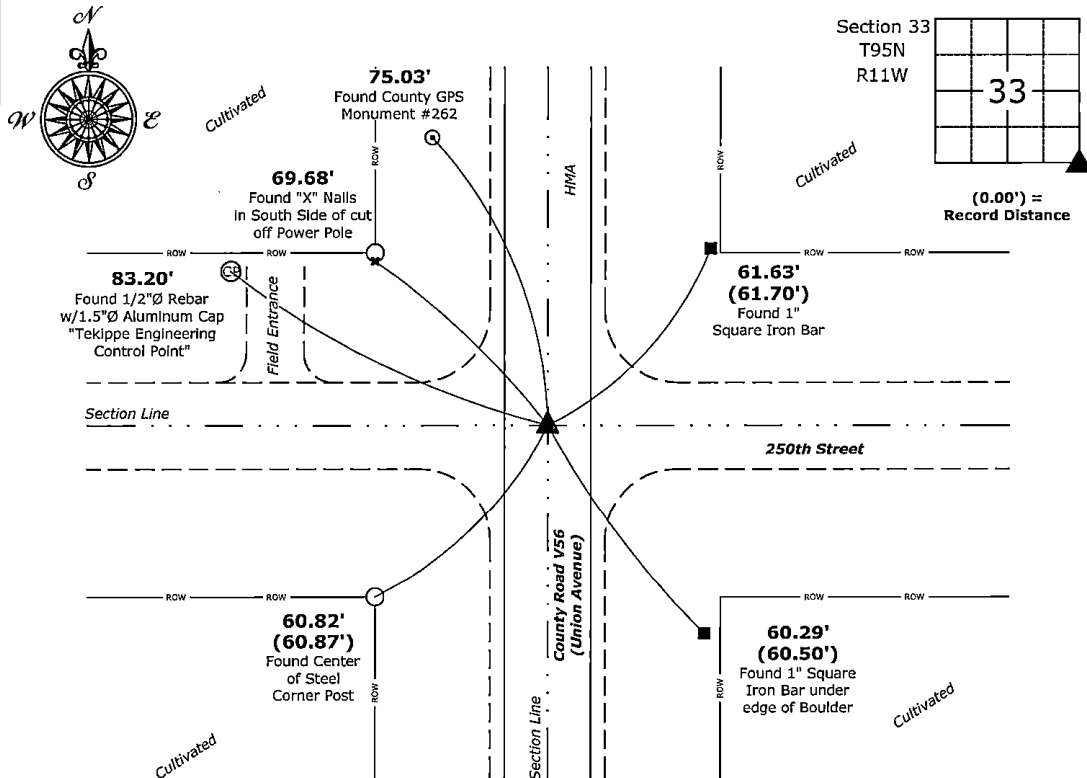

Southeast Corner of Section 33-95-11
Set 5/8"Ø Rebar w/2"Ø Aluminum Cap PLS 19211



I hereby certify that this land surveying document was prepared and the related survey work was performed by me or under my direct personal supervision and that I am a duly licensed Land Surveyor under the laws of the State of Iowa.

Kirk D. Reicks 2-25-2026
Kirk D. Reicks Date:

License Number 19211
My License Renewal Date is December 31, 2026.
Sheets covered by this seal: Individual sheet only

List Corner to be Indexed

Corner	Section	Township	Range
SE	33	95	11

Project Number: 2026-021

FB: Chickasaw 14, Page(s) 41

File: S:_Projects - NHO\County Control Systems\CHICKASAW\CHICK-37-2026.dwg, 2/25/2026 1:34:47 PM

Section 34-96-11
As referred to in
Engr. Tie Book

FILED 2004 - 1352
RECORDER'S OFFICE
CHICKASAW COUNTY, IOWA
2004 JUN 14 AM 9 30
CINDY MESSERSMITH
COUNTY RECORDER

TEKIPPE ENGINEERING, P.C., 128 South Vine Street, West Union, Iowa 52175 Phone (563) 422-5131

UNITED STATES PUBLIC LAND SURVEY CORNER CERTIFICATE

OF
Land Survey Monuments situated in Section 34, Township 96 North, Range
11 West of the Fifth Principal Meridian, CHICKASAW County, Iowa.
Previously recorded in none in County Recorder's Office.
(book, page, document number, etc.)


(Show reason for preparing this certificate, the evidence and detailed procedures used in establishing the corner positions and monumentation found or placed.)

Monument Description and Remarks: NW Corner Section 3 T94N R11W: Found PK nail with information obtained from the Chickasaw County Engineer's Office in Field Book Stapleton Twp., Section 33, Corner 'B'.


N 1/4 Corner Section 3 T94N R11W: Found 2" gas pipe with information obtained from the Chickasaw County Engineer's Office in Field Book Stapleton Twp., Section 34, Corner 'A'. Set 1/2" rebar w/2" aluminum cap PLS 16961 in found pipe.

PLAN - VIEW

(Show a minimum of three reference ties to durable physical objects, relevant monuments and physical conditions that will enable recovery of the corner.)

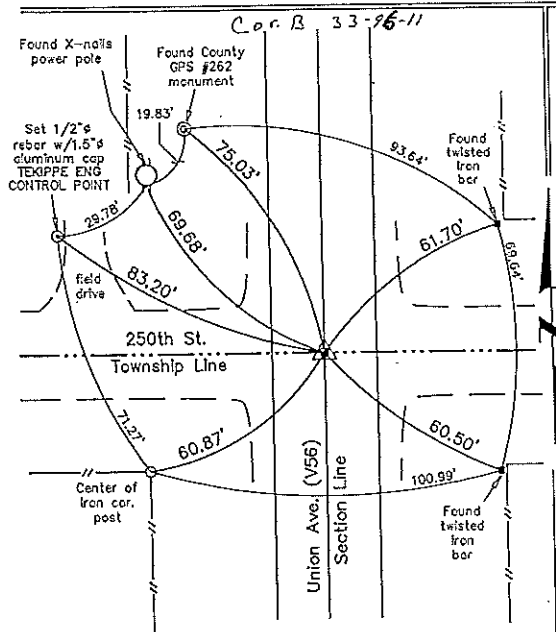

NW Corner Section 3 T94N R11W
Found PK nail

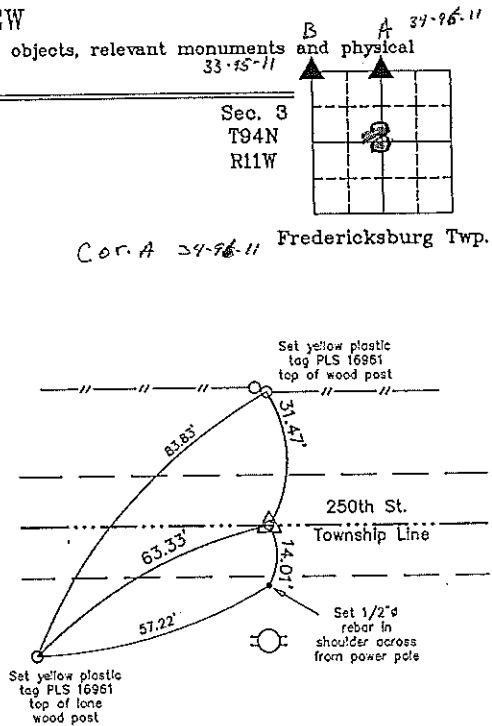

N 1/4 Corner Section 3 T94N R11W
Found 2" gas pipe. Set 1/2" rebar w/2" aluminum cap PLS 16961 in found pipe



I hereby certify that this land surveying document was prepared and the related survey work was performed by me or under my direct personal supervision and that I am a duly licensed Land Surveyor under the laws of the State of Iowa.

Michael J. Shimak June 13, 2004
Michael J. Shimak Date

License number 16961
My license renewal date is December 31, 2005.
Sheets covered by this seal: Individual

List Corners to be Indexed			
Corners	Section	Twp.	Range
NW	3	94N	11W
N 1/4	3	94N	11W

X:\Section Corners\Sec. 03\3-94-11ac.dwg
Project Number 04107.LS
FB 46L PG. 3-5

COUNTY ENGINEER'S
COPY