

Instrument #: 2021-2579
 11/17/2021 09:24:30 AM Total Pages: 1
 SCC SECTION CORNER CERTIFICATES
 Recording Fee: \$ 7.00
 Shirley Troyna, Recorder, Chickasaw County Iowa



Prepared by & Return to: Herold - Reicks Surveying, 10 East Main Street, New Hampton, IA 50659, Ph. 641-394-2725

United States Public Land Survey Corner Certificate

Land Survey Monument situated in
 Section 5, Township 94 North, Range 11 West of the Fifth Principal Meridian, Chickasaw County, Iowa.
 On file in Book 158, Page 403 in the County Recorder's office.

This certificate is being prepared in compliance with Iowa Code Chapter 355.11 because:


- There is no certificate on file for this corner.
- There are no longer three valid ties of record.
- There are changes to reference ties of record.
- There is change of monumentation of record.
- To clarify description of record monument (ties).

Monument Description and Remarks:

East 1/4 Corner: Set 5/8"Ø Rebar w/Aluminum Cap PLS 19211 at record location with information obtained from a Survey and Plat made by Paul R. Herold, as recorded in Document #2002-1691 on file in the County Recorder's Office. (Buried Monument 18"Ø Deep)

Plan View

(Show a minimum of three reference ties to durable physical objects, relevant monuments and physical conditions that will enable recovery of the corner.)

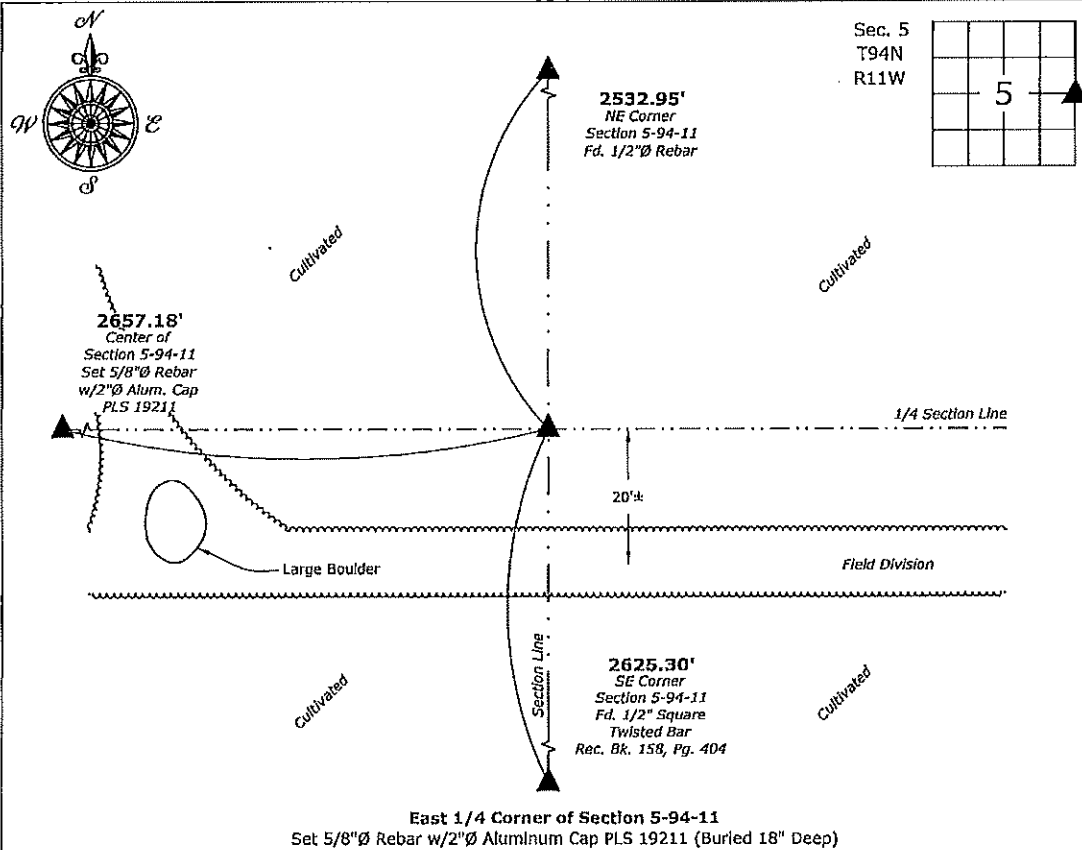

Cor C
 5-94-11

Fig. S:_Projects - NHO\County Control Systems - NHO\CHICKASAW\CHICK-43 (F-Burg)\CHICK-43 - 2021.dwg, 11/16/2021 12:58:16 PM

East 1/4 Corner of Section 5-94-11
 Set 5/8"Ø Rebar w/2"Ø Aluminum Cap PLS 19211 (Buried 18" Deep)



I hereby certify that this land surveying document was prepared and the related survey work was performed by me or under my direct personal supervision and that I am a duly licensed Land Surveyor under the laws of the State of Iowa.
Kirk D. Reicks 11-16-2021
 Kirk D. Reicks Date:
 License number 19211
 My license renewal date is December 31, 2022.
 Sheets covered by this seal: Individual sheet only

List Corner to be Indexed			
Corner	Section	Twp.	Range
E 1/4	5	94	11
Project Number: 2021-111			
FB: Chickasaw 11, Pgs. 16-20			