

Instrument #: 2021-2587
 11/17/2021 09:24:30 AM Total Pages: 1
 SCC SECTION CORNER CERTIFICATES
 Recording Fee: \$ 7.00
 Shirley Troyna, Recorder, Chickasaw County Iowa



Prepared by & Return to: Herald - Reicks Surveying, 10 East Main Street, New Hampton, IA 50659, Ph. 641-394-2725

United States Public Land Survey Corner Certificate

Land Survey Monument situated in
 Section 5, Township 94 North, Range 11 West of the Fifth Principal Meridian, Chickasaw County, Iowa.
 Not on file in the County Recorder's office.

This certificate is being prepared in compliance with Iowa Code Chapter 355.11 because:


- There is no certificate on file for this corner.
- There are no longer three valid ties of record.
- There are changes to reference ties of record.
- There is change of monumentation of record.
- To clarify description of record monument (ties).

Monument Description and Remarks:

Southwest Corner of the NW 1/4 - NW 1/4: Found 1/2"Ø Rebar w/Orange Plastic Cap PLS 7060 as Witness Corner. Found Monument on Section Line, 4.20' North of True Corner with information obtained from a Survey and Plat made by Lyle G. Tekippe, as recorded in Book 141, Page 205 on file in the County Recorder's Office.

Plan View

(Show a minimum of three reference ties to durable physical objects, relevant monuments and physical conditions that will enable recovery of the corner.)

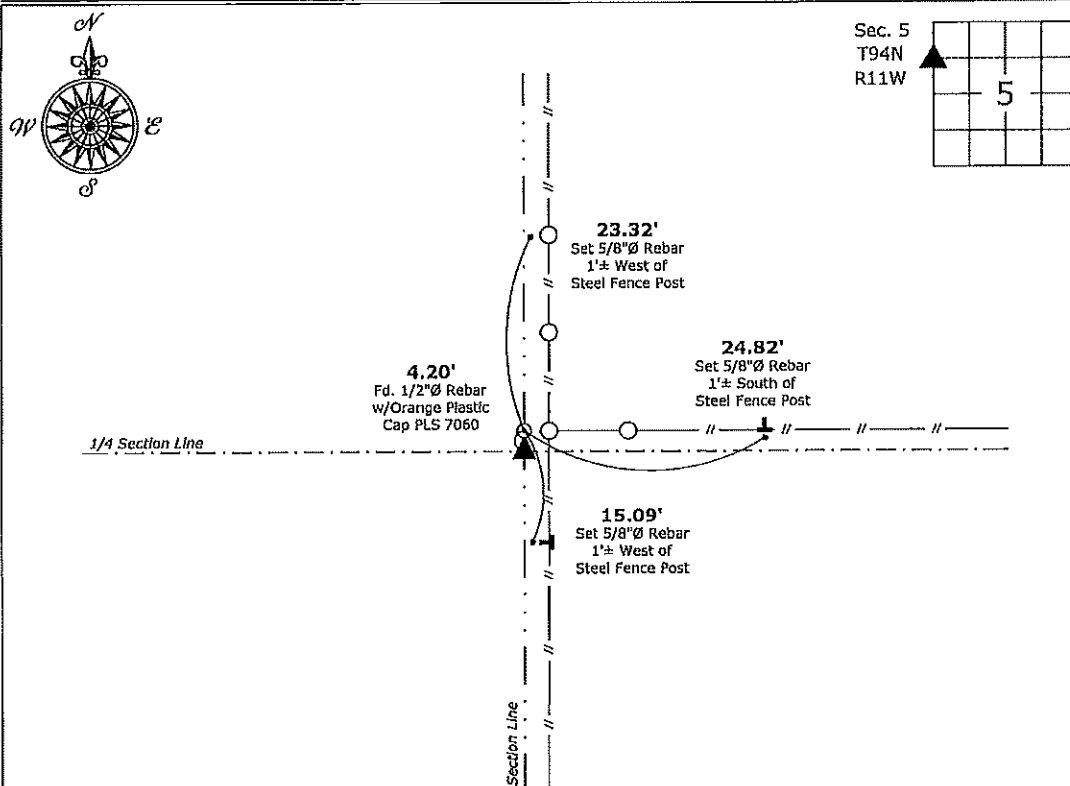

Southwest Corner of the NW 1/4 - NW 1/4 of Section 5-94-11
 Found 1/2"Ø Rebar w/Orange Plastic Cap PLS 7060 as Witness Corner



I hereby certify that this land surveying document was prepared and the related survey work was performed by me or under my direct personal supervision and that I am a duly licensed Land Surveyor under the laws of the State of Iowa.

Kirk D. Reicks 11-16-2021
 Kirk D. Reicks Date:

License number 19211
 My license renewal date is December 31, 2022.
 Sheets covered by this seal: Individual sheet only

List Corner to be Indexed			
Corner	Section	Twp.	Range
SW-NW-NW	5	94	11

Project Number: 2021-111
 F8: Chickasaw 11, Pgs. 16-20

Cor C1
 6-94-11

File: S:_Projects - NHO\County Control Systems - NHO\CHICKASAW\CHICK-43 - 2021.dwg, 11/16/2021 4:08:07 PM