

Chickasaw Co. Recorder
 Cindy Messersmith
Fee Book 2017-0133
 01/30/2017 @0241PM
 SEC COR CERT # Pages: 1
 Book: Page: \$7.00
 Total Fees:

Prepared by & Return to: Herald - Reicks Surveying, 10 East Main Street, New Hampton, IA 50659, Ph. 641-391-2725

United States Public Land Survey Corner Certificate

Land Survey Monument situated in
 Section 8, Township **94** North, Range **11** West of the Fifth Principal Meridian, **Chickasaw** County, Iowa.
 Not on file in the County Recorder's office.

This certificate is being prepared in compliance with Iowa Code Chapter 355.11 because:



- There is no certificate on file for this corner.
- There are no longer three valid ties of record.
- There are changes to reference ties of record.
- There is change of monumentation of record.
- To clarify description of record monument (ties).


Monument Description and Remarks:

West 1/4 Corner: Set 5/8"Ø rebar w/2"Ø aluminum cap PLS 19211 at an existing wood division post after comparing the position to adjacent corners in said Section.

An extensive search of all of the records within the County offices was performed as part of the section corner recovery. No records were located of the perpetuation of a monument at this corner.

Plan View

(Show a minimum of three reference ties to durable physical objects, relevant monuments and physical conditions that will enable recovery of the corner.)

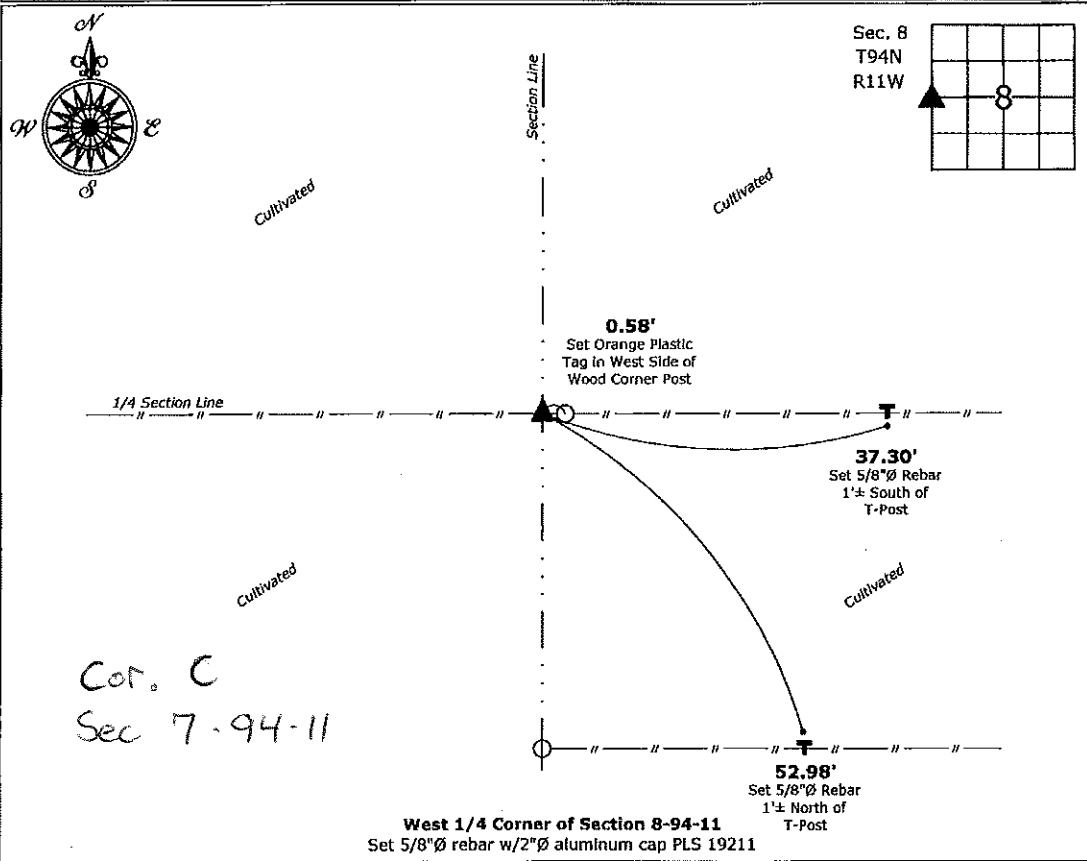

I hereby certify that this land surveying document was prepared and the related survey work was performed by me or under my direct personal supervision and that I am a duly licensed Land Surveyor under the laws of the State of Iowa.

Kirk D. Reicks 1-16-17
 Kirk D. Reicks Date:
 License number 19211
 My license renewal date is December 31, 2018.
 Sheets covered by this seal: Individual sheet only

List Corner to be Indexed

Corner	Section	Twp.	Range
W 1/4	8	94	11

Project Number: 2017-001

FB: Chickasaw County Pgs. 26-27

File: S:\CGD Projects\County Control Systems\CHICKASAW\CHICK-43 (F-Burg)\CHICK-43.dwg, 1/16/2017 3:09:22 PM