

Instrument #: 2021-2580
 11/17/2021 09:24:30 AM Total Pages: 1
 SCC SECTION CORNER CERTIFICATES
 Recording Fee: \$ 7.00
 Shirley Troyna, Recorder, Chickasaw County Iowa



Prepared by & Return to: Herold - Reicks Surveying, 10 East Main Street, New Hampton, IA 50659, Ph. 641-994-2725

United States Public Land Survey Corner Certificate

Land Survey Monument situated in
 Section 5, Township 94 North, Range 11 West of the Fifth Principal Meridian, **Chickasaw** County, Iowa.
 On file in **Book 172, Page 51** in the County Recorder's office.

This certificate is being prepared in compliance
 with Iowa Code Chapter 355.11 because:



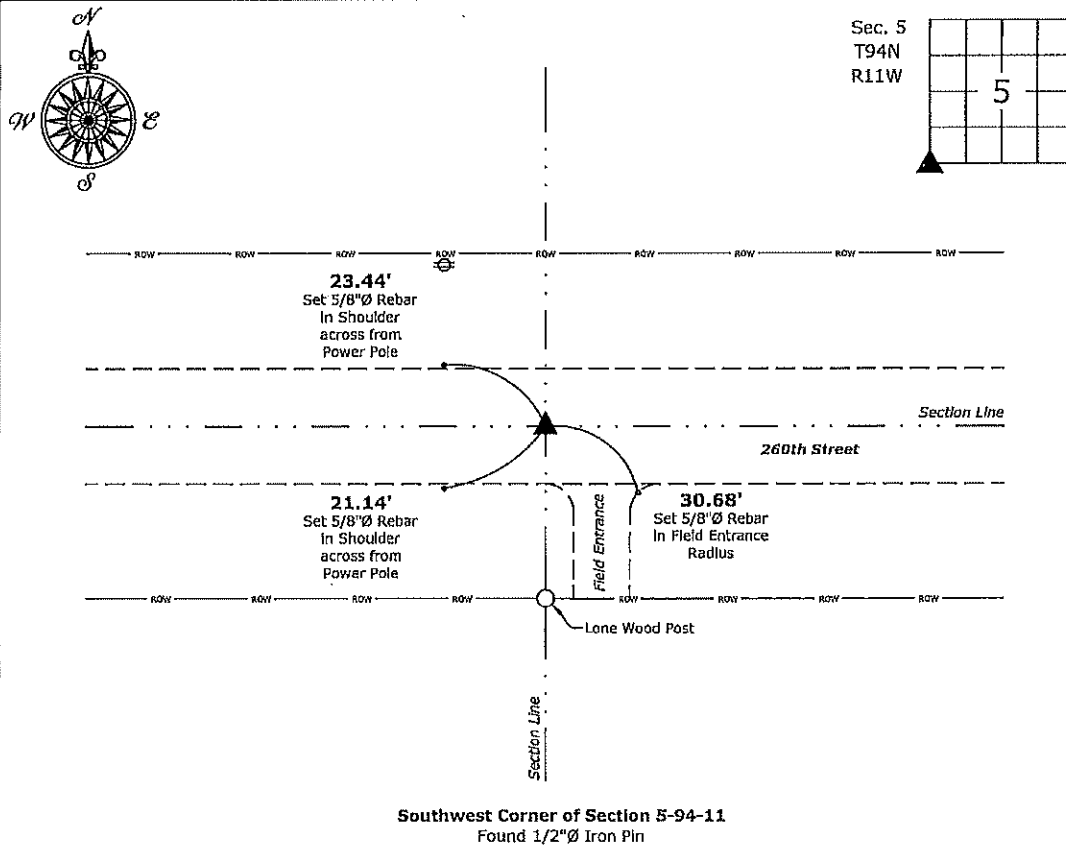
- ☐ There is no certificate on file for this corner.
- ☒ There are no longer three valid ties of record.
- ☐ There are changes to reference ties of record.
- ☐ There is change of monumentation of record.
- ☐ To clarify description of record monument (ties).

Monument Description and Remarks:

Southwest Corner: Found 1/2"Ø Iron Pin with information obtained from the previously recorded Section Corner Certificate.

Plan View

(Show a minimum of three reference ties to durable physical objects, relevant monuments and physical conditions that will enable recovery of the corner.)



Cor B
 6-94-11



I hereby certify that this land surveying document was prepared and the related survey work was performed by me or under my direct personal supervision and that I am a duly licensed Land Surveyor under the laws of the State of Iowa.

Kirk D. Reicks 11-16-2021
 Kirk D. Reicks Date:

License number 19211
 My license renewal date is December 31, 2022.
 Sheets covered by this seal: Individual sheet only

List Corner to be Indexed

Corner	Section	Twp.	Range
SW	5	94	11

Project Number: 2021-111

FB: Chickasaw 11, Pgs. 16-20

File: S:_Projects - IHO\County Control Systems - IHO\CHICKASAW\CHICK-43 (F-Burg)\CHICK-43 - 2021.dwg, 11/16/2021 12:50:28 PM

DOCUMENT No. **02902**RECORDING FEE \$ **6.00**

TRANSFER FEE \$

FILED FOR RECORD THE **9th** DAY OF**June** 19 **99** AT **8:53**O'CLOCK **A** M. BOOK **172** PAGE **51**

STATE OF IOWA, CHICKASAW COUNTY:

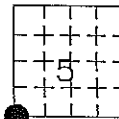
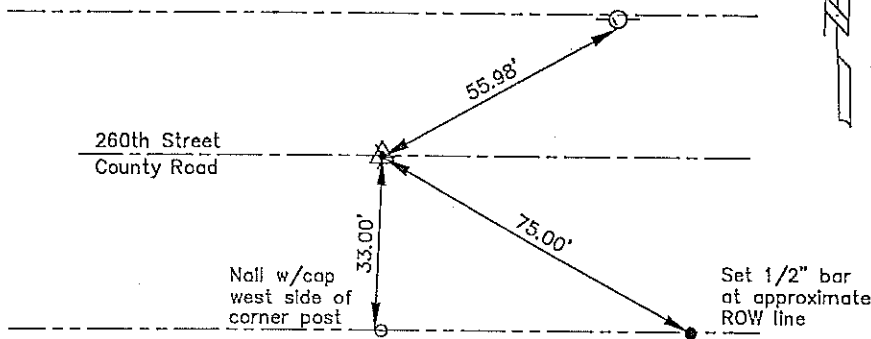
By **Cindy Messersmith** RecorderBy **Shelly M. Payne** DeputyPrepared by: Erdman Engineering, P.C. 708 Commerce Drive, P.O. Box 246, Decorah, Iowa 52101
Phone (319)382-4194, Fax (319)382-3623

United States Public Land Survey Corner Certificate

6 ofLand Survey Monuments situated in Section **5** Township **94** Range **11** of the Fifth Principle Meridian,
Chickasaw County, Iowa. Previously recorded in does not apply in County Recorders Office.

Monument Description and Remarks: This certificate is prepared in accordance with Section 355.11 of the 1995 Code of Iowa. No previous certificate has been filed for this corner location. We found no record of the SW of Section 5 being set. We found no evidence of the corner in the field other than a corner post at the south right-of-way line of the county road. Based on this we set a 1/2" bar w/cap Iowa RLS #11442 33.00' north of the corner post, at the center of the 66' wide County Road Right-Of-Way. The distance of 2667.86' from the S 1/4 Corner to the SW Corner matches the distance as used on a survey done by L.P. Erdman in 1977 for the Plat recorded in Book 113 page 93, in the Chickasaw County Recorder's Office.

Plan-View

Nail w/cap
south side of
Power Pole

Cor B

6-94-11

I hereby certify that the survey work was completed and this certificate was prepared by me or under my direct supervision and that I am a duly registered land surveyor under the laws of the State of Iowa.

Signature

Lindsay Erdman, P.E. and L.S.

Date: **6/7/99** Reg. No. **11442**

My license renewal date is December 31, 2000.

List Corners to be Indexed

Corners	Section	Twp.	Range
SW	5	94	11

m:\c\veg\p\chick\89058\89058.w