

Instrument #: 2021-2580  
 11/17/2021 09:24:30 AM Total Pages: 1  
 SCC SECTION CORNER CERTIFICATES  
 Recording Fee: \$ 7.00  
 Shirley Troyna, Recorder, Chickasaw County Iowa



Prepared by & Return to: Herold - Reicks Surveying, 10 East Main Street, New Hampton, IA 50659, Ph. 641-994-2725

### United States Public Land Survey Corner Certificate

Land Survey Monument situated in  
 Section 5, Township 94 North, Range 11 West of the Fifth Principal Meridian, Chickasaw County, Iowa.  
 On file in **Book 172, Page 51** in the County Recorder's office.

This certificate is being prepared in compliance with Iowa Code Chapter 355.11 because:


- There is no certificate on file for this corner.
- There are no longer three valid ties of record.
- There are changes to reference ties of record.
- There is change of monumentation of record.
- To clarify description of record monument (ties).

#### Monument Description and Remarks:

**Southwest Corner:** Found 1/2"Ø Iron Pin with information obtained from the previously recorded Section Corner Certificate.

### Plan View

(Show a minimum of three reference ties to durable physical objects, relevant monuments and physical conditions that will enable recovery of the corner.)

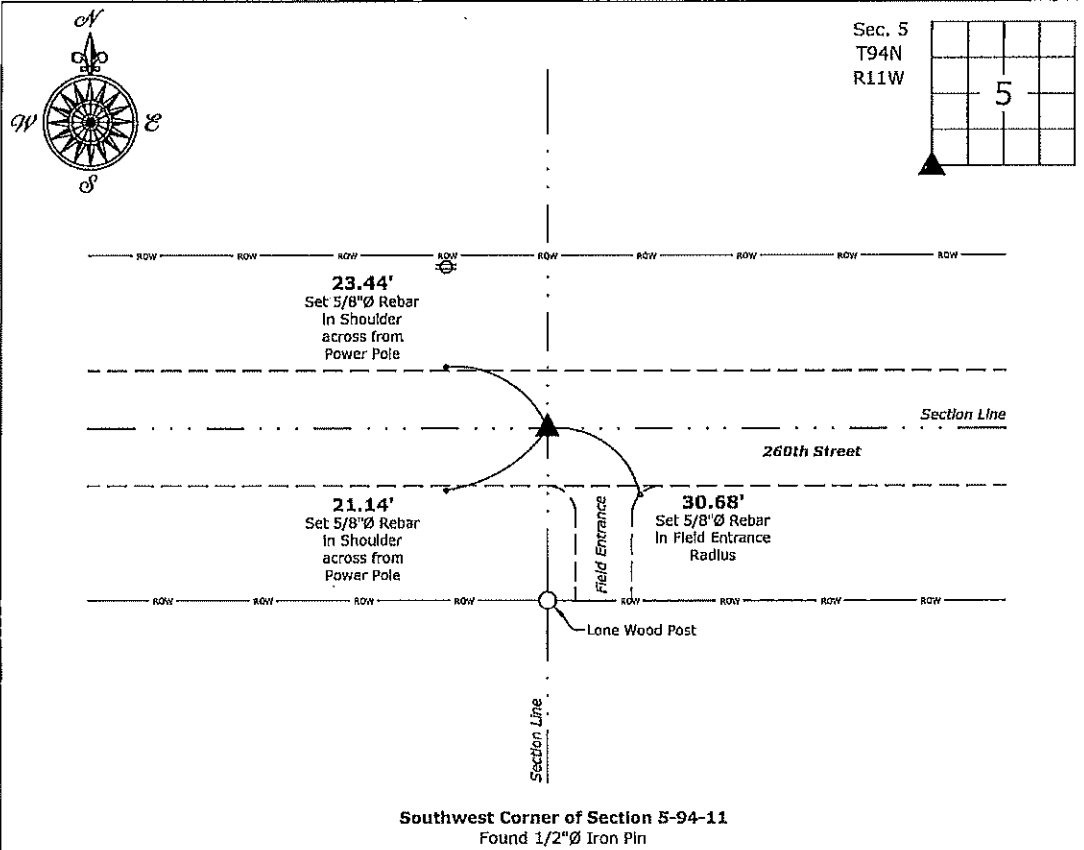

Cor B  
 6-94-11

File: S:\Projects - IHO\CHICKASAW\CHICK-43 (F-Burg)\CHICK-43 - 2021.dwg, 11/16/2021 12:58:28 PM

**Southwest Corner of Section 5-94-11**  
 Found 1/2"Ø Iron Pin



I hereby certify that this land surveying document was prepared and the related survey work was performed by me or under my direct personal supervision and that I am a duly licensed Land Surveyor under the laws of the State of Iowa.

*Kirk D. Reicks* 11-16-2021  
 Kirk D. Reicks Date:

License number 19211  
 My license renewal date is December 31, 2022.  
 Sheets covered by this seal: Individual sheet only

#### List Corner to be Indexed

Corner	Section	Twp.	Range
SW	5	94	11

Project Number: 2021-111  
 FB: Chickasaw 11, Pgs. 16-20