

DOCUMENT No. **00376** FILED FOR RECORD THE 1st DAY OF September 1995 AT 8:30 O'CLOCK A.M. BOOK 158 Deeds PAGE 404
 RECORDING FEE \$ 6.00 By Leitha N. Ross Recorder
 TRANSFER FEE \$ ----- Deputy

UNITED STATES PUBLIC LAND SURVEY CORNER CERTIFICATE OF

Land Survey Monuments situated in Section 4, Township 94 North, Range 11 West, of the Fifth Principal Meridian, CHICKASAW County, Iowa.
 Previously recorded in NONE in County Recorder's Office.
(book, page, document number, etc.)


(Show reason for preparing this certificate, the evidence and detailed procedures used in establishing the corner positions and monumentation found or placed.)

Monument Description and Remarks: SW CORNER SECTION 4 T94N R11W: FOUND 1/2" SQUARE TWISTED IRON BAR @ E OF 260TH ST. ON LINE WITH A SOUTH FENCE LINE, BAR WAS FOUND APPROX. 0.3 DEEP


S1/4 CORNER SECTION 4 T94N R11W: FOUND 5/8" SQUARE TWISTED IRON BAR @ E OF 260TH ST. BAR WAS FOUND APPROX. 0.5 DEEP

PLAN - VIEW

(Show a minimum of three reference ties to durable physical objects, relevant monuments and physical conditions that will enable recovery of the corner.)

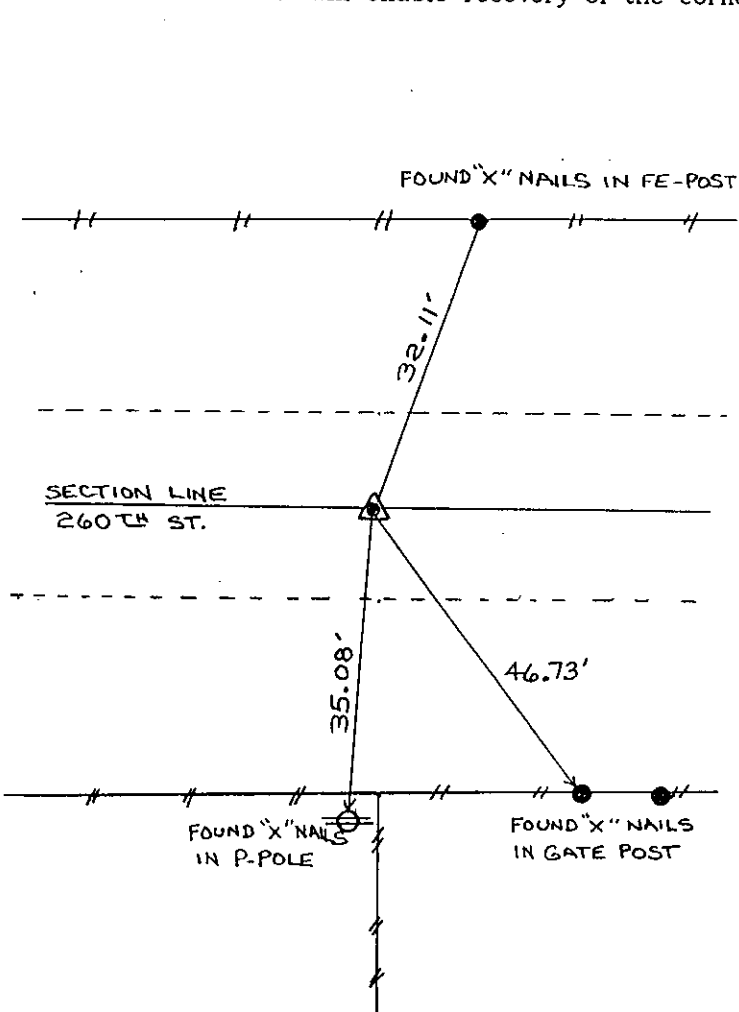

SW CORNER SECTION 4 T94N R11W

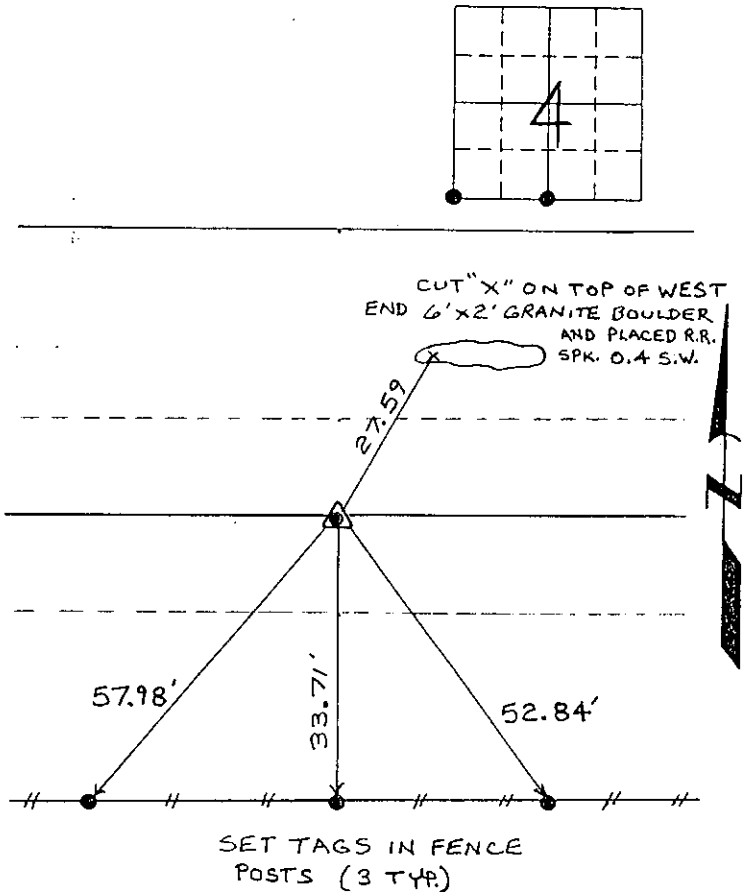


S1/4 CORNER SECTION 4 T94N R11W

I hereby certify that the survey work was completed and this certificate was prepared by me or under my direct personal supervision and that I am a duly registered land surveyor under the laws of the state of Iowa.

Signature: Lyle G. TeKippe
Lyle G. TeKippe

Date: 8-22-95 Reg. No. 7060
My Registration Renewal Date is December 31, 1996

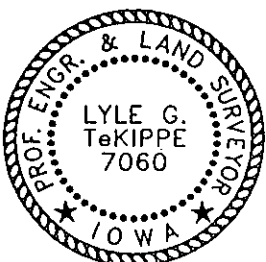

Seal

List Corners to be Indexed			
Corners	Section	Twp.	Range
SW COR.	4	94N	11W
S1/4 COR.	4	94N	11W

Instrument #: 2021-2576
11/17/2021 09:24:30 AM Total Pages: 1
SCC SECTION CORNER CERTIFICATES
Recording Fee: \$ 7.00
Shirley Troyna, Recorder, Chickasaw County Iowa



Prepared by & Return to: Harold - Reicks Surveying, 10 East Main Street, New Hampton, IA 50659, Ph. 641-394-2725

United States Public Land Survey Corner Certificate

Land Survey Monument situated in
Section 5, Township 94 North, Range 11 West of the Fifth Principal Meridian, Chickasaw County, Iowa.
On file in **Book 158, Page 404** in the County Recorder's office.

This certificate is being prepared in compliance
with Iowa Code Chapter 355.11 because:


- ☐ There is no certificate on file for this corner.
☒ There are no longer three valid ties of record.
☐ There are changes to reference ties of record.
☐ There is change of monumentation of record.
☐ To clarify description of record monument (ties).

Monument Description and Remarks:

Southeast Corner: Found 1/2" Square Twisted bar with information obtained from the previously recorded
Section Corner Certificate.

Plan View

(Show a minimum of three reference ties to durable physical objects, relevant monuments and physical conditions that will enable recovery of the corner.)

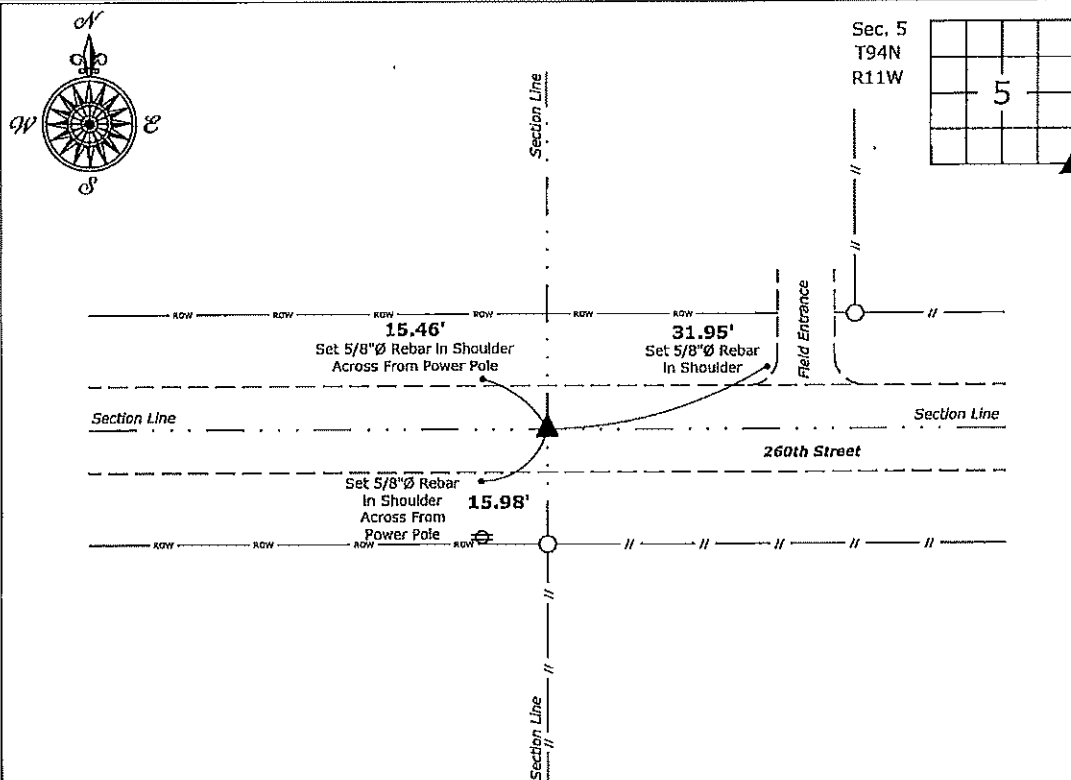

Southeast Corner of Section 5-94-11
Found 1/2" Square Twisted Bar



I hereby certify that this land surveying document
was prepared and the related survey work was
performed by me or under my direct personal
supervision and that I am a duly licensed Land
Surveyor under the laws of the State of Iowa.

Kirk D. Reicks 11-16-2021

Kirk D. Reicks Date:

License number 19211

My license renewal date is December 31, 2022.

Sheets covered by this seal: Individual sheet only

List Corner to be Indexed

Corner	Section	Twp.	Range
SE	5	94	11

Project Number: 2021-111

FB: Chickasaw 11, Pgs. 16-20

File: S:\Projects - NHO\County Control Systems - NHO\CHICKASAW\CHICK-43 - 2021.dwg, 11/16/2021 12:56:35 PM

Cor B
5-94-11