

Herold - Reicks Surveying, 10 East Main Street, New Hampton, IA 50659, Ph. 641-384-2725, Fax. 641-384-2710

UNITED STATES PUBLIC LAND SURVEY CORNER CERTIFICATE


Land Survey Monuments situated in Section 3, Township 94 North, Range 11 West of the Fifth Principal Meridian, Chickasaw County, Iowa. Not previously recorded in the County Recorder's office.

This certificate is being prepared in compliance with Iowa Code Chapter 355.11 because:

- There is no certificate on file for this corner.
- There are no longer three valid ties of record.
- There are changes to reference ties of record.
- There is change of monumentation of record.
- To clarify description of record monument (ties).

Monument Description and Remarks:
Southwest Corner: Found P.K. nail with information obtained at the County Engineer's office.

PLAN - VIEW
 (Show a minimum of three reference ties to durable physical objects, relevant monuments and physical conditions that will enable recovery of the corner.)

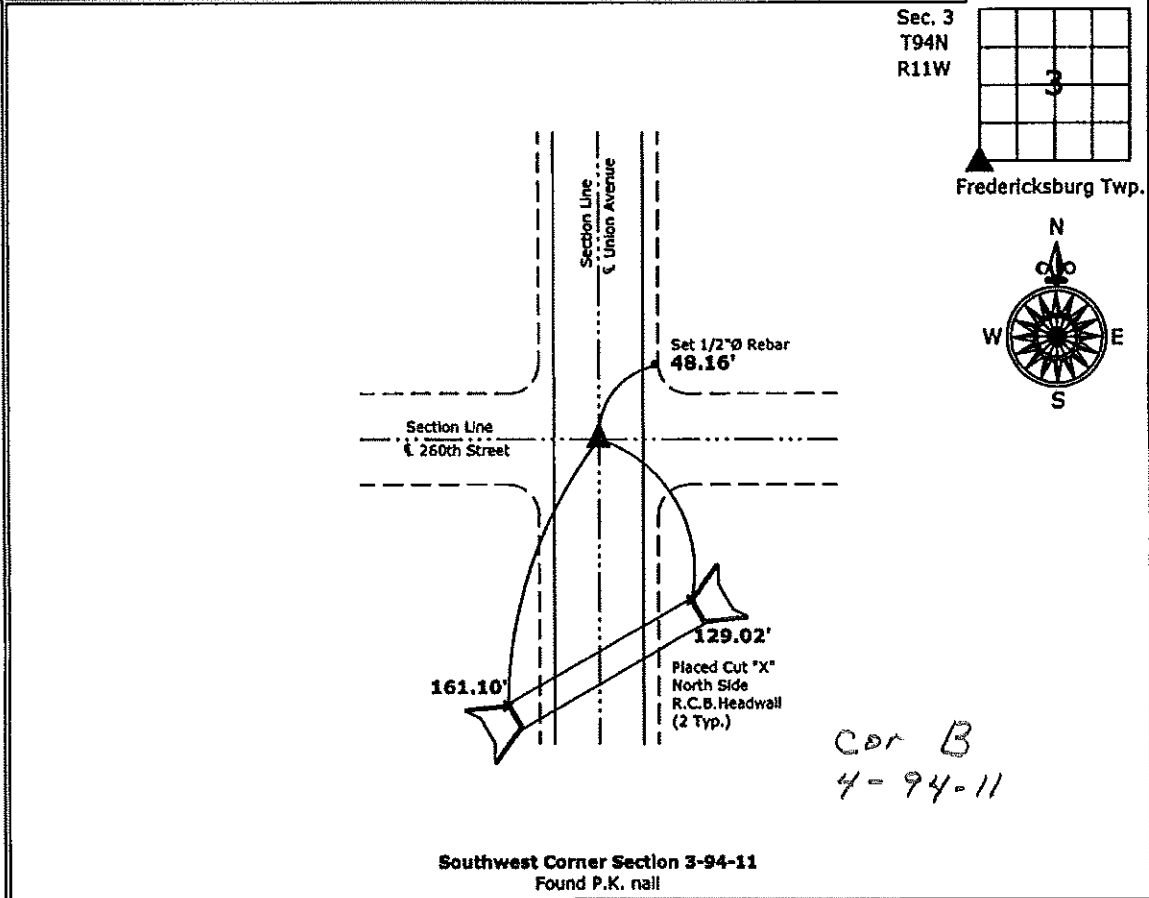

	I hereby certify that this land surveying document was prepared and the related survey work was performed by me or under my direct personal supervision and that I am a duly licensed Land Surveyor under the laws of the State of Iowa. <i>Kirk D. Reicks</i> 12-8-10 Kirk D. Reicks Date:	List Corners to be Indexed									
	License number 19211 My license renewal date is December 31, 2010. Sheets covered by this seal: Individual sheet only	<table border="1" style="width: 100%; border-collapse: collapse;"> <thead> <tr> <th>Corners</th> <th>Section</th> <th>Twp.</th> <th>Range</th> </tr> </thead> <tbody> <tr> <td style="text-align: center;">SW</td> <td style="text-align: center;">3</td> <td style="text-align: center;">94</td> <td style="text-align: center;">11</td> </tr> </tbody> </table>	Corners	Section	Twp.	Range	SW	3	94	11	Project Number: 2010-126 FB: Chickasaw County 2, Pg. 51
Corners	Section	Twp.	Range								
SW	3	94	11								