

UNITED STATES PUBLIC LAND SURVEY CORNER CERTIFICATE

OF

Land Survey Monuments situated in Section 2, Township 96 North, Range 12 West, of the Fifth Principal Meridian, CHICKASAW County, Iowa. Previously recorded in NONE in County Recorder's Office.


(Show reason for preparing this certificate, the evidence and detailed procedures used in establishing the corner positions and monumentation found or placed.)

Monument Description and Remarks: SW CORNER SECTION 2 T96N R12W: FOUND 3/4" SQUARE IRON BAR FROM INFORMATION OBTAINED FROM THE COUNTY ENGINEERS OFFICE, IN FIELD BOOK "JACKSONVILLE TWP. CORNER TIES".

E 1/4 CORNER SECTION 2 T96N R12W: FOUND 1/2" Ø REBAR FROM INFORMATION OBTAINED FROM THE COUNTY ENGINEERS OFFICE, IN FIELD BOOK "JACKSONVILLE TWP CORNER TIES".

PLAN - VIEW

(Show a minimum of three reference ties to durable physical objects, relevant monuments and physical conditions that will enable recovery of the corner.)

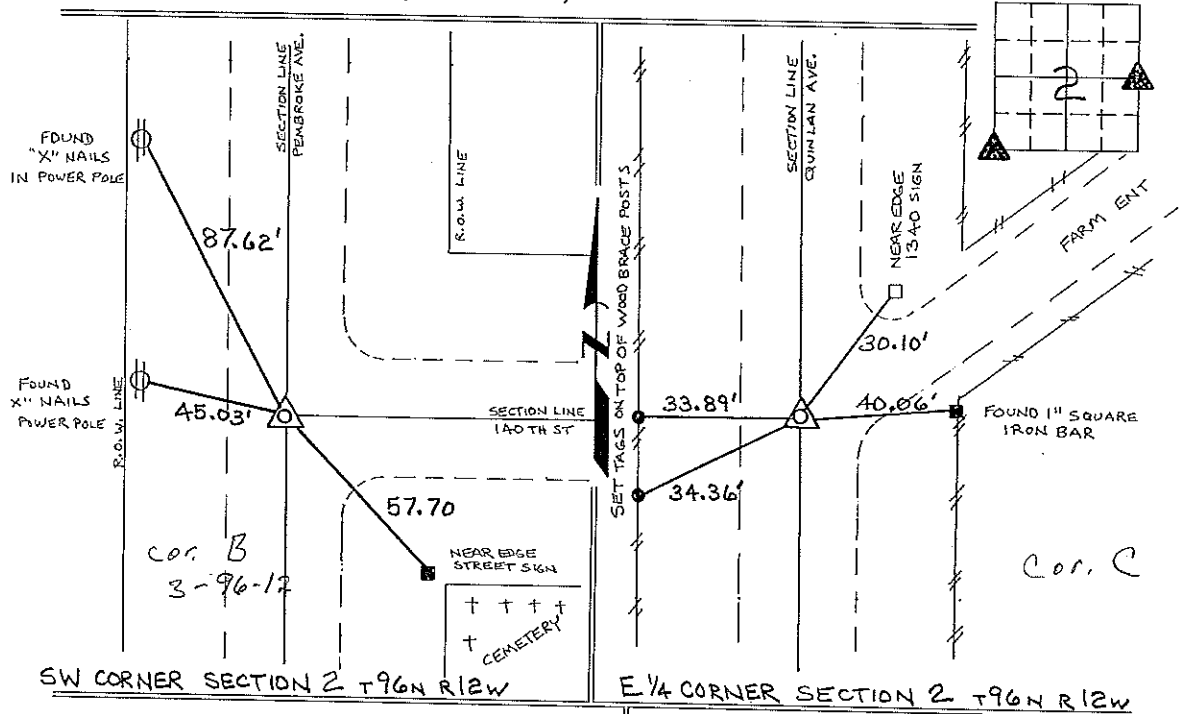

I hereby certify that the survey work was completed and this certificate was prepared by me or under my direct personal supervision and that I am a duly registered land surveyor under the laws of the state of Iowa.

Signature: Lyle G. TeKippe
Lyle G. TeKippe

Date: 5-24-96 Reg. No. 7080
My Registration Renewal Date is December 31, 1998

Seal



List Corners to be Indexed			
Corners	Section	Twp.	Range
SW	2	96N	12W
	Corner B	3-96-12	
E 1/4	2	96N	12W
	Corner C	2-96-12	

*Placed in file
B.P.C. 6/17/96*