

Instrument #: 2020-2557
 11/12/2020 11:10:59 AM Total Pages: 1
 SCC SECTION CORNER CERTIFICATES
 Recording Fee: \$ 7.00
 Shirley Troyna, Recorder, Chickasaw County Iowa



Prepared by & Return to: Herold - Reicks Surveying, 10 East Main Street, New Hampton, IA 50658, Ph. 641-394-2725

United States Public Land Survey Corner Certificate

Land Survey Monument situated in
 Section 11, Township 96 North, Range 12 West of the Fifth Principal Meridian, % County, Iowa.
 Not on file in the County Recorder's office.

This certificate is being prepared in compliance with Iowa Code Chapter 355.11 because:



- There is no certificate on file for this corner.
- There are no longer three valid ties of record.
- There are changes to reference ties of record.
- There is change of monumentation of record.
- To clarify description of record monument (ties).


Monument Description and Remarks:

Northwest Corner of the NE 1/4 - NW 1/4 : Set 5/8"Ø Rebar with Aluminum Cap PLS 19211 equidistant and on line between the Northwest and North 1/4 Corners of said Section.

An extensive search of all of the records within the County offices was performed as part of the section corner recovery. There were no records located of the perpetuation of a monument at this corner.

Plan View

(Show a minimum of three reference ties to durable physical objects, relevant monuments and physical conditions that will enable recovery of the corner.)

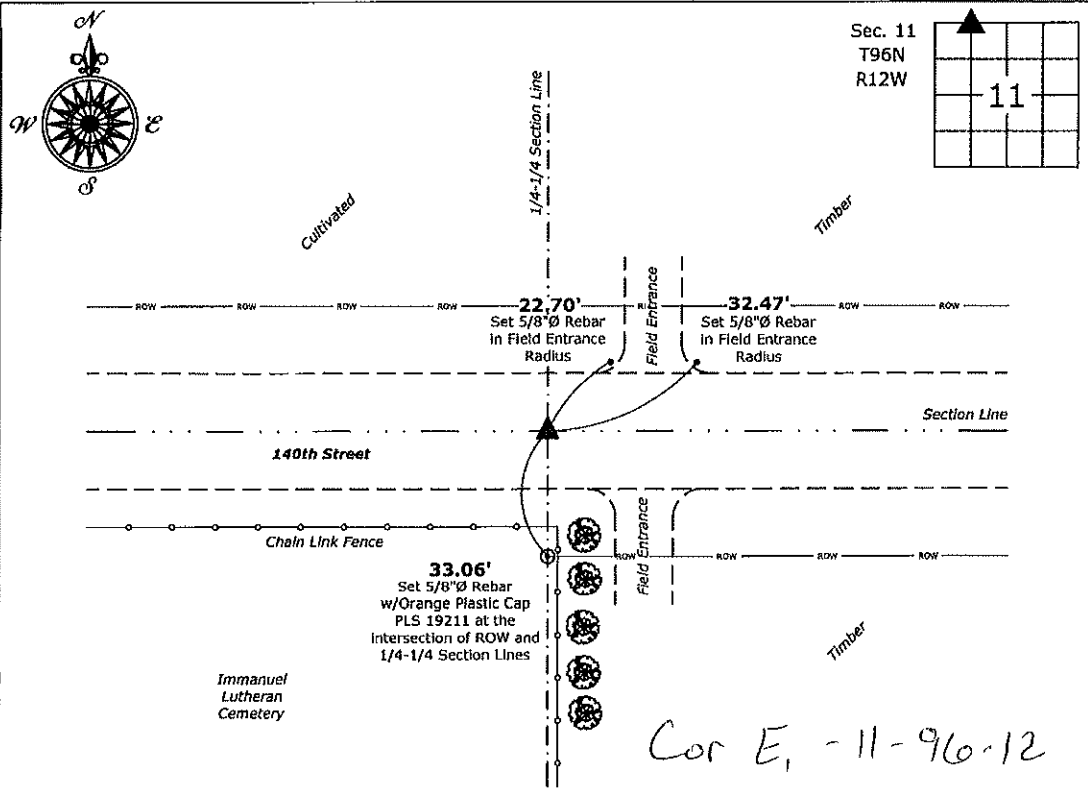

Northwest Corner of the NE 1/4 - NW 1/4 of Section 11-96-12
 Set 5/8"Ø Rebar w/2"Ø Aluminum Cap PLS 19211

Cor E, - 11-96-12



I hereby certify that this land surveying document was prepared and the related survey work was performed by me or under my direct personal supervision and that I am a duly licensed Land Surveyor under the laws of the State of Iowa.

Kirk D. Reicks 11-10-2020
 Kirk D. Reicks Date:

License number 19211
 My license renewal date is December 31, 2020.
 Sheets covered by this seal: Individual sheet only

List Corner to be Indexed			
Corner	Section	Twp.	Range
NW-NE-NW	11	96	12

Project Number: 2020-109

FB: Chickasaw 10, Pgs. 40-41

File: S:\Projects - NHO\County Control Systems - NHO\CHICKASAW\CHICK-14 - 2020.dwg, 11/10/2020 8:03:14 AM