

Instrument #: 2020-2432
 10/26/2020 04:03:48 PM Total Pages: 1
 SCC SECTION CORNER CERTIFICATES
 Recording Fee: \$ 7.00
 Shirley Troyna, Recorder, Chickasaw County Iowa



Prepared by & Return to: Herold - Reicks Surveying, 10 East Main Street, New Hampton, IA 50659, Ph. 648-394-2725

United States Public Land Survey Corner Certificate

Land Survey Monument situated in
 Section 14, Township 96 North, Range 12 West of the Fifth Principal Meridian, Chickasaw County, Iowa.
 Not on file in the County Recorder's office.

This certificate is being prepared in compliance with Iowa Code Chapter 355.11 because:




- There is no certificate on file for this corner.
- There are no longer three valid ties of record.
- There are changes to reference ties of record.
- There is change of monumentation of record.
- To clarify description of record monument (ties).

Monument Description and Remarks:

North 1/4 Corner: Found 1/2" Square Twisted Bar with information obtained from the County Engineer's Office in Field Book Jacksonville Twp. Corner Ties, Section 11, Corner A.

Plan View

(Show a minimum of three reference ties to durable physical objects, relevant monuments and physical conditions that will enable recovery of the corner.)

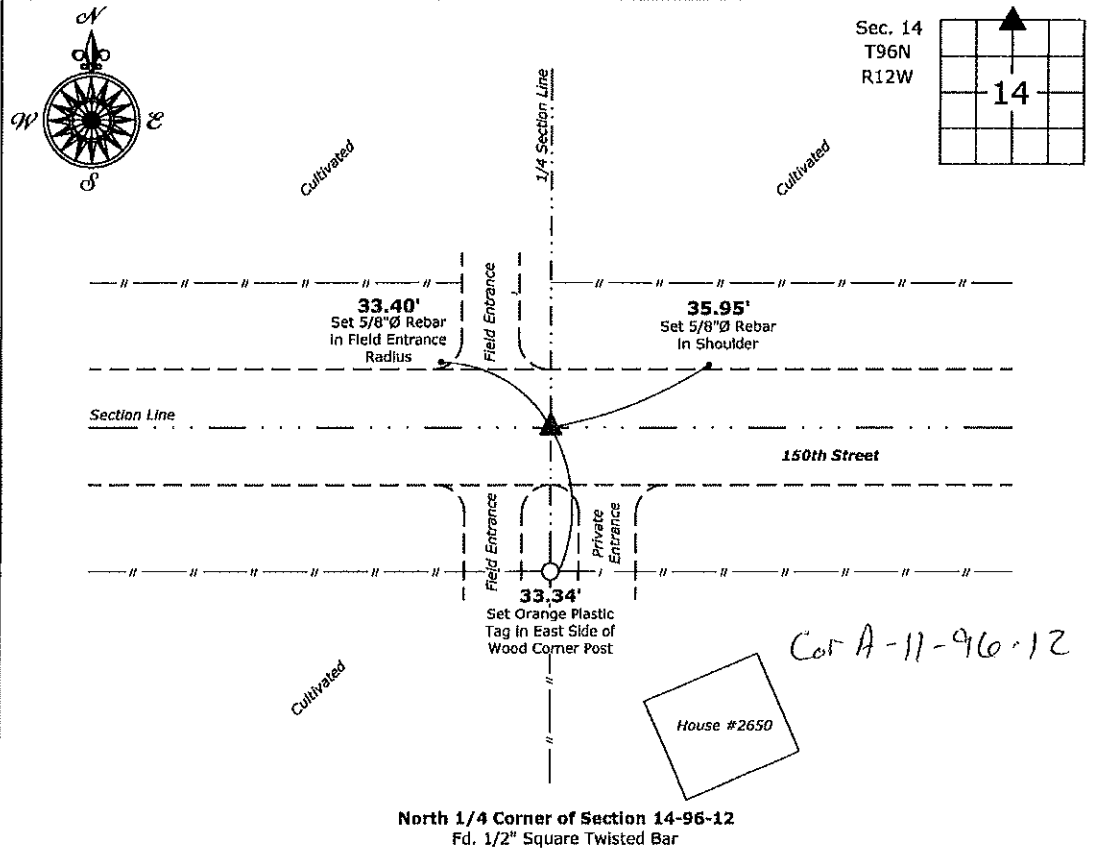

North 1/4 Corner of Section 14-96-12
 Fd. 1/2" Square Twisted Bar



I hereby certify that this land surveying document was prepared and the related survey work was performed by me or under my direct personal supervision and that I am a duly licensed Land Surveyor under the laws of the State of Iowa.
Kirk D. Reicks 10-22-2020
 Kirk D. Reicks Date:
 License number 19211
 My license renewal date is December 31, 2020.
 Sheets covered by this seal: Individual sheet only

List Corner to be Indexed			
Corner	Section	Twp.	Range
N 1/4	14	96	12
Project Number: 2020-110			
FB: Chickasaw 10, Pgs. 35-37			

File: S:\Projects - NHO\County Control Systems - NHO\CHICKASAW\CHICK-14 - 2020.dwg, 10/22/2020 7:14:08 AM