

Chickasaw Co. Recorder
 Cindy Messersmith
Fee Book 2007-1301
 06/25/2007 @0354PM
 SCC SEC COR CERT # Pages: 1
 Book: Page: # Pages: 1
 Total Fees: \$7.00

Herold - Rocks Surveying, 25 1/2 East Main Street, Suite 204, New Hampton, IA 50659, Ph. 641-394-2725

UNITED STATES PUBLIC LAND SURVEY CORNER CERTIFICATE

Land Survey Monuments situated in:
 Section 8, Township 96 North, Range 12 West of the Fifth Principal Meridian,
Chickasaw County, Iowa. Previously recorded in Book 146, Page 82
 in County Recorder's Office. (book, page, document number, etc.)



(Show reason for preparing this certificate, the evidence and detailed procedures used in establishing the corner positions and monumentation found or placed.)

Monument Description and Remarks:

S 1/4 Corner - Found 1"Ø Iron Pin from previous section corner certificate. Added 2 new ties.

PLAN - VIEW

(Show a minimum of three reference ties to durable physical objects, relevant monuments and physical conditions that will enable recovery of the corner.)

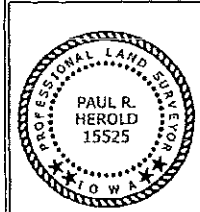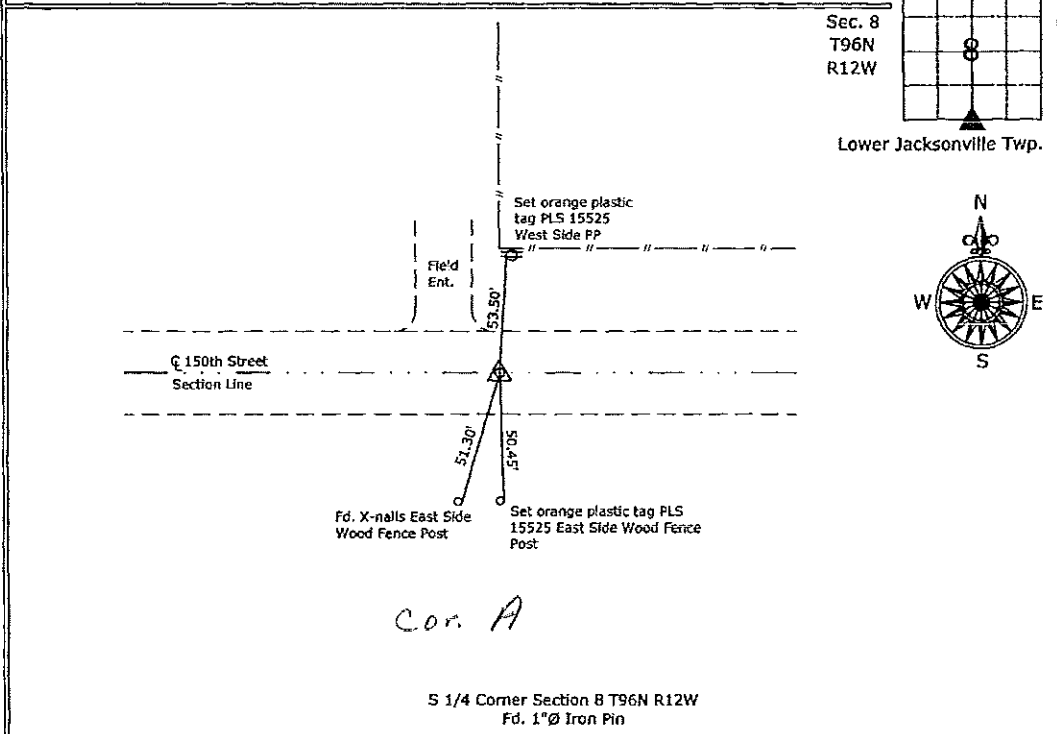

I hereby certify that this land surveying document was prepared and the related survey work was performed by me or under my direct personal supervision and that I am a duly licensed Land Surveyor under the laws of the State of Iowa.
Paul R. Herold 6-22-07
 Paul R. Herold Date:
 License number 15525
 My license renewal date is December 31, 2008.
 Sheets covered by this seal: Individual sheet only

List Corners to be Indexed			
Corners	Section	Twp.	Range
S 1/4	8	T96N	R12W


Project Number: 2007-061
 FB: Chickasaw County 1, Pgs. 27-28

File: S:\Projects\2007\2007-061\map\2007-061.dwg, 6/21/2007 2:28:07 PM


SECTION CORNER CERTIFICATE

OF

Land Survey Monuments Situated in Section: 8
 Township: 96 N
 Range: 12 W
 Township Name: JACKSONVILLE
 County: CHICKASAW

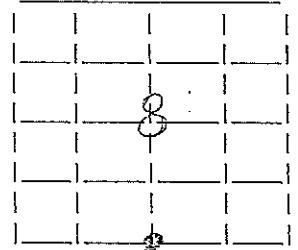

Recovery Tie Drawing

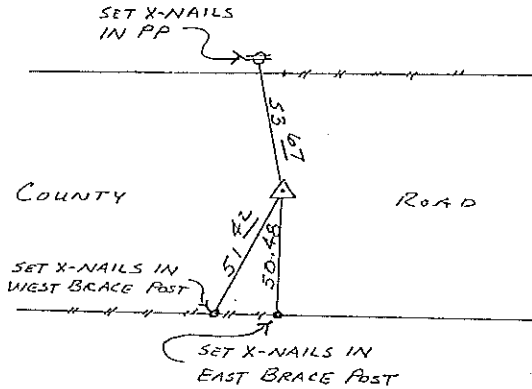

Entered Tie book 11/90 JFM

Cor A


5/4 CORNER SECTION 8-96-12

Previously Recorded in Book _____ Page _____ Previously Recorded in Book _____ Page _____

Reason for preparing certificate: NO CERTIFICATE ON FILE

Evidence and detailed procedures in establishing corner position: FOUND 1" Ø SMOOTH IRON PIN

I hereby certify that the survey work was completed and this certificate was prepared by me or under my direct personal supervision and that I am a duly Registered Land Surveyor under the laws of the State of Iowa.

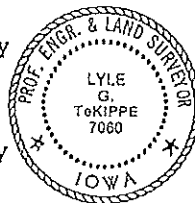

List Corners to be Indexed

Corners	Section	Twp	Range
S 1/4 CORNER	8	T 96 N	R 12 W
N 1/4 CORNER	17	T 96 N	R 12 W

Lyle G. TeKippe
 Lyle G. TeKippe Reg. No. 7060

Date: 11-16-90

146-82