

Prepared by: Kyle A. Johnson Address: 1900 MEDICAL ARTS AVE S, SUITE 100 SARTELL, MN Phone: 1-888-937-5150

UNITED STATES PUBLIC LAND SURVEY CORNER CERTIFICATE FOR

Land survey monuments situated in Section 17, Township 96 NORTH  
12 WEST, of the Fifth Principal Meridian, CHICKASAW County, Iowa.  
 Previously Recorded in \_\_\_\_\_ in County Recorder's Office.

(Show reason for preparing this certificate, the evidence and detailed procedures used in establishing the corner positions and monumentation found or placed.)

MONUMENT DESCRIPTION AND REMARKS:


**SOUTHEAST CORNER:** Westwood Professional Services found a 3/4" square bar 0.6' deep ±5' southwest of centerline intersection. Accepting corner location as the best available evidence and set 3 ties. Filing corner record as there is no certificate on file for this corner.

**SOUTH QUARTER:** Westwood Professional Services found a 5/8" rebar near centerline which is in line with North fence and South field line. Accepting corner location as best available evidence and set 3 ties. Filing corner record as there is no certificate on file for this corner.

**WEST QUARTER:** Westwood Professional Services found a survey spike with IDOT Washer near centerline and in line with fence East. Accepting corner location and tie to 4 existing concrete monuments. The survey spike agrees with other local monumentation along this road. Filing corner record as there is no certificate on file for this corner.

PLAN - VIEW

(Show a minimum of three reference ties to durable physical objects, relevant monuments and physical conditions that will enable recovery of the corner.)

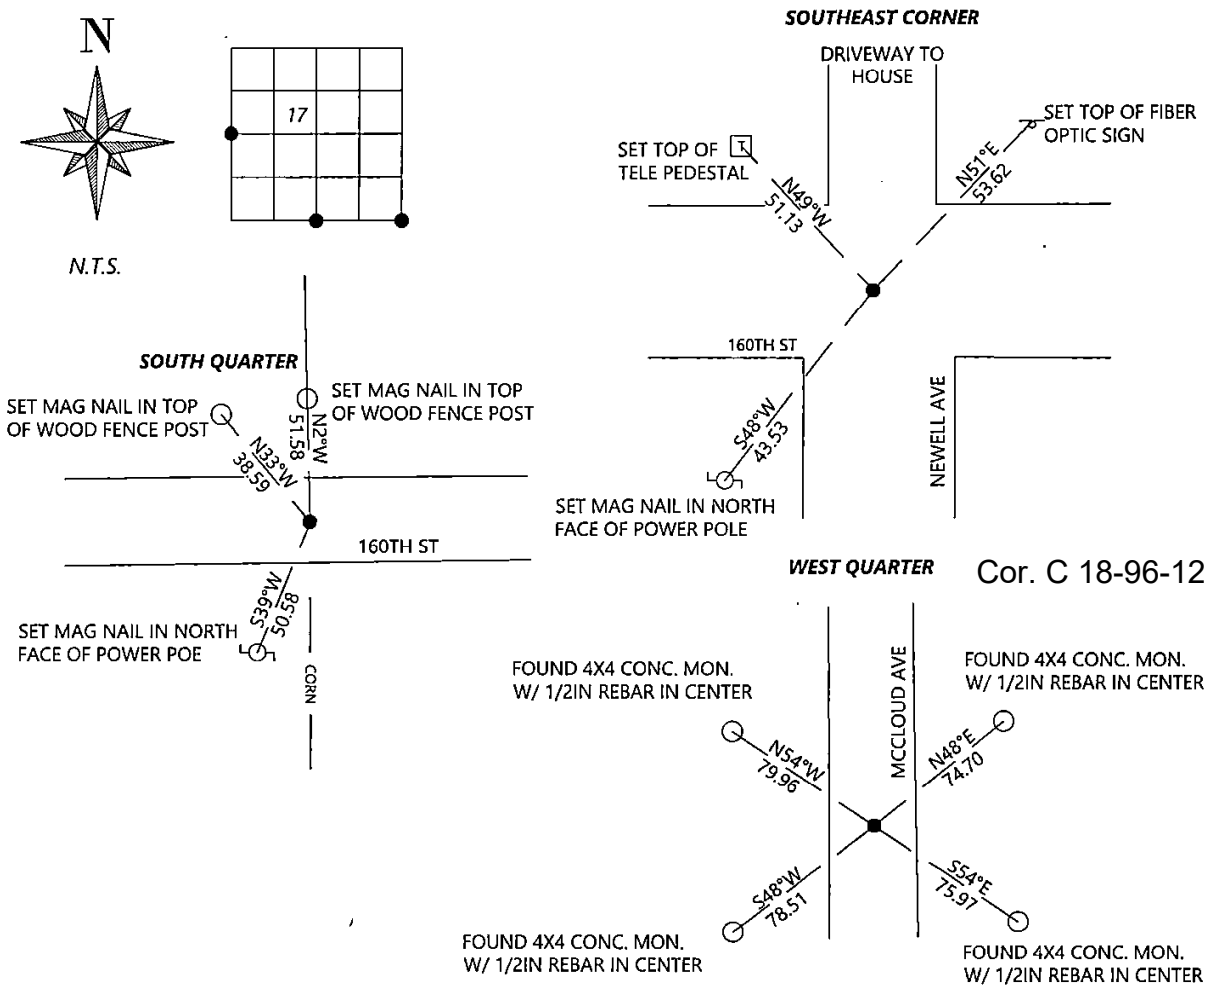

I hereby certify that this land surveying document was prepared and the related survey work was performed by me or under my direct personal supervision and that I am a duly licensed Land Surveyor under the laws of the state of Iowa.

Signature: Kyle A. Johnson Date: 10/4/2022  
 Typed/Printed Name: Kyle A. Johnson  
 License Number: 25725  
 My license renewal date is December 31, 2022  
 Pages or sheets covered by this seal: THIS SHEET

Corners to be Indexed

Corners	Section	Twp.	Range
SQ	17	96	12
SE	17	96	12
WQ	17	96	12