

Prepared by & Return to Herold - Recks Surveying, 10 East Main Street, New Hampton, IA 50658, Ph. 641-354-2725

UNITED STATES PUBLIC LAND SURVEY CORNER CERTIFICATE

Land Survey Monuments situated in Section 1, Township 96 North, Range 12 West of the Fifth Principal Meridian, Chickasaw County, Iowa. 1., 2.) Not previously recorded in the County Recorder's office.

This certificate is being prepared in compliance with Iowa Code Chapter 355.11 because:

- 1 & 2 There is no certificate on file for this corner.
 There are no longer three valid ties of record.
 There are changes to reference ties of record.
 There is change of monumentation of record.
 To clarify description of record monument (ties).


Monument Description and Remarks:

1.) Northwest Corner NE 1/4-NW 1/4: Set 5/8"Ø rebar with 2"Ø aluminum cap PLS 15525 equidistant and online between the Northwest and North 1/4 Corners of Section 1.

2.) Northeast Corner NW 1/4-NE 1/4: Set 5/8"Ø rebar with 2"Ø aluminum cap PLS 15525 equidistant and online between the North 1/4 and Northeast Corners of Section 1.

PLAN - VIEW

(Show a minimum of three reference ties to durable physical objects, relevant monuments and physical conditions that will enable recovery of the corner.)

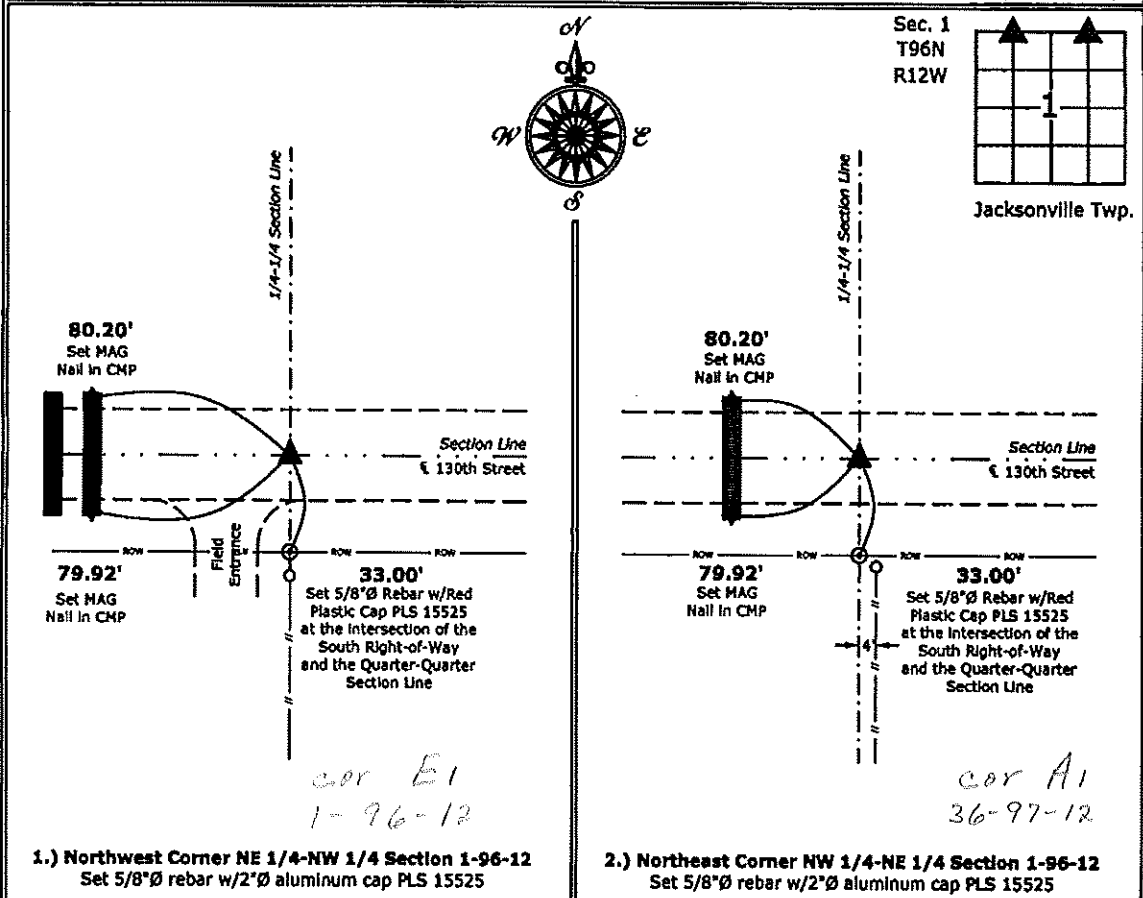

1.) Northwest Corner NE 1/4-NW 1/4 Section 1-96-12
 Set 5/8"Ø rebar w/2"Ø aluminum cap PLS 15525

2.) Northeast Corner NW 1/4-NE 1/4 Section 1-96-12
 Set 5/8"Ø rebar w/2"Ø aluminum cap PLS 15525



I hereby certify that this land surveying document was prepared and the related survey work was performed by me or under my direct personal supervision and that I am a duly licensed Land Surveyor under the laws of the State of Iowa.

Paul R. Herold 5-16-13
 Paul R. Herold Date:

License number 15525
 My license renewal date is December 31, 2014.
 Sheets covered by this seal: Individual sheet only

List Corners to be Indexed

| Corners | Section | Twp. | Range |
|----------|---------|------|-------|
| NW-NE-NW | 1 | 96 | 12 |
| NE-NW-NE | 1 | 96 | 12 |

Project Number: 2013-086

FB: Chickasaw 5, Pgs. 47-49