

Instrument #: 2022-1874  
 10/14/2022 03:34:21 PM Total Pages: 1  
 SCC SECTION CORNER CERTIFICATES  
 Recording Fee: \$ 7.00  
 Shirley Trayna, Recorder, Chickasaw County Iowa



Prepared by: Kyle A. Johnson Address: 1900 MEDICAL ARTS AVE S, SUITE 100 SARTELL, MN Phone: 1-888-937-5150

UNITED STATES PUBLIC LAND SURVEY CORNER CERTIFICATE FOR

Land survey monuments situated in Section 26, Township 96 NORTH  
12 WEST, of the Fifth Principal Meridian, CHICKASAW County, Iowa.  
 Previously Recorded in \_\_\_\_\_ in County Recorder's Office.

(Show reason for preparing this certificate, the evidence and detailed procedures used in establishing the corner positions and monumentation found or placed.)


MONUMENT DESCRIPTION AND REMARKS:

**WEST QUARTER:** Westwood Professional Services found a 5/8" rebar 0.2' deep and 2 ties from 1995 record. Accepting corner location and set 1 tie. Filing corner record as the monument of record has changed and there are no longer 3 valid ties of record.


**SOUTH QUARTER:** Westwood Professional Services found a 1/2" rebar with illegible cap and 2 ties per engineers tie book. Accepting corner location and set 2 ties. Filing corner record as there is no certificate on file for this corner.

PLAN - VIEW


(Show a minimum of three reference ties to durable physical objects, relevant monuments and physical conditions that will enable recovery of the corner.)

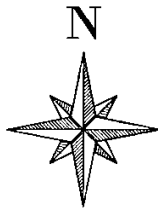

N.T.S.

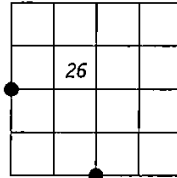

Cor. C 27-96-12

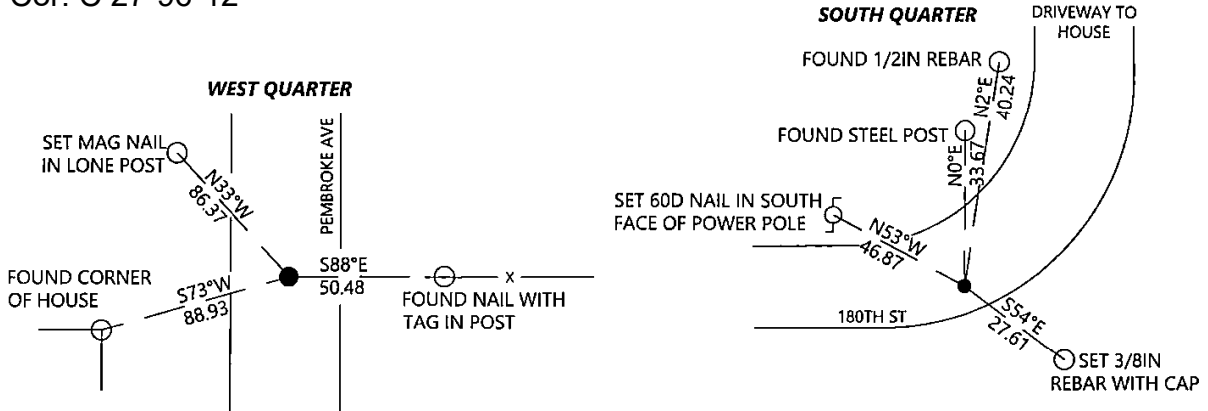

SEAL	<p>I hereby certify that this land surveying document was prepared and the related survey work was performed by me or under my direct personal supervision and that I am a duly licensed Land Surveyor under the laws of the state of Iowa.</p> <p><i>Kyle A. Johnson</i>      10/14/2022          Signature      Date</p> <p>Typed/Printed Name: <u>Kyle A. Johnson</u></p> <p>License Number: <u>25725</u></p> <p>My license renewal date is December 31, <u>2022</u></p> <p>Pages or sheets covered by this seal: <u>THIS SHEET</u></p>	<p>Corners to be Indexed</p> <table border="1"> <thead> <tr> <th>Corners</th> <th>Section</th> <th>Twp.</th> <th>Range</th> </tr> </thead> <tbody> <tr> <td>WQ</td> <td>26</td> <td>96</td> <td>12</td> </tr> <tr> <td>SQ</td> <td>26</td> <td>96</td> <td>12</td> </tr> </tbody> </table>	Corners	Section	Twp.	Range	WQ	26	96	12	SQ	26	96	12
Corners	Section	Twp.	Range											
WQ	26	96	12											
SQ	26	96	12											

