

RECORDING FEE \$ 5.00 | December 19, 92 AT 8:44 | MARY C. MURRAY, Recorder
 S TRANSFER FEE \$ 0.00 | O'CLOCK A.M. BOOK 151 PAGE 57 | MARY C. MURRAY
 B. L. H. S. R. S. Deputy
 SLO 19-92

UNITED STATES PUBLIC LAND SURVEY CORNER CERTIFICATE

OF



Land Survey Monuments situated in Section 30, Township 96 North, Range 12 West, of the Fifth Principal Meridian, Chickasaw County, Iowa. Previously recorded in none in County Recorder's Office.

(Show reason for preparing this certificate, the evidence and detailed procedures used in establishing the corner positions and monumentation found or placed.)

Monument Description and Remarks: Found monument as described below. Measured in new ties as shown.

PLAN - VIEW

(Show a minimum of three reference ties to durable physical objects, relevant monuments and physical conditions that will enable recovery of the corner.)

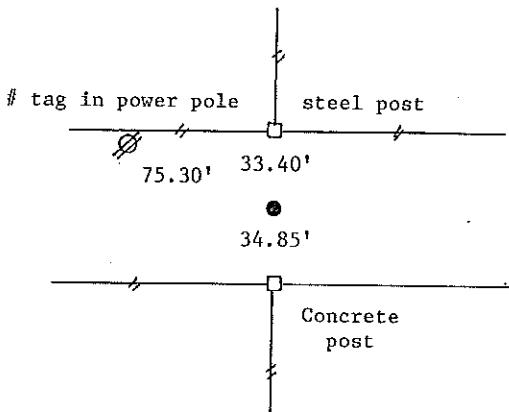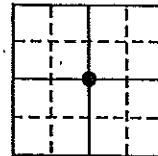

Center section. Found 5/8" pipe
with cap #2886

Cor. O

I hereby certify that the survey work was completed and this certificate was prepared by me or under my direct personal supervision and that I am a duly registered land surveyor under the laws of the state of Iowa.

Signature: Steve Busse
Name typed or printed: STEVE BUSSE

Date: 10/28/92 Reg. No. 9018

Corners	Section	List Corners to be Indexed	Twp	Range
center	30	96	12	

Placed
in Tie
Box
10/28/92

SEAL

