

FILED 2001 - 0544

RECORDER'S OFFICE
CHICKASAW COUNTY, IOWA

2001 MAR 27 AM 8 36

CINDY MESSERSMITH
COUNTY RECORDER

TeKIPPE ENGINEERING, P.C., 128 South Vine Street, West Union, Iowa 52175 Phone (319) 422-5131

UNITED STATES PUBLIC LAND SURVEY CORNER CERTIFICATE

OF

Land Survey Monuments situated in Section 19, Township 96 North, Range 12 West of the Fifth Principal Meridian, CHICKASAW County, Iowa.
Previously recorded in none in County Recorder's Office.
(book, page, document number, etc.)

(Show reason for preparing this certificate, the evidence and detailed procedures used in establishing the corner positions and monumentation found or placed.)



Monument Description and Remarks: E 1/4 Corner Section 19 T96N R12W: Found hinge nail in ACC mat.SE Corner Section 19 T96N R12W: Found hinge nail in ACC mat.

NOTE: Both corners were found with information obtained from as-built plans for U.S. Highway 63 Project #FR-63-8(13)--2G-19.

PLAN -- VIEW

Project Number 01014.15
FR 481 PG. 13-18

(Show a minimum of three reference ties to durable physical objects, relevant monuments and physical conditions that will enable recovery of the corner.)

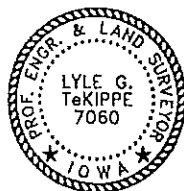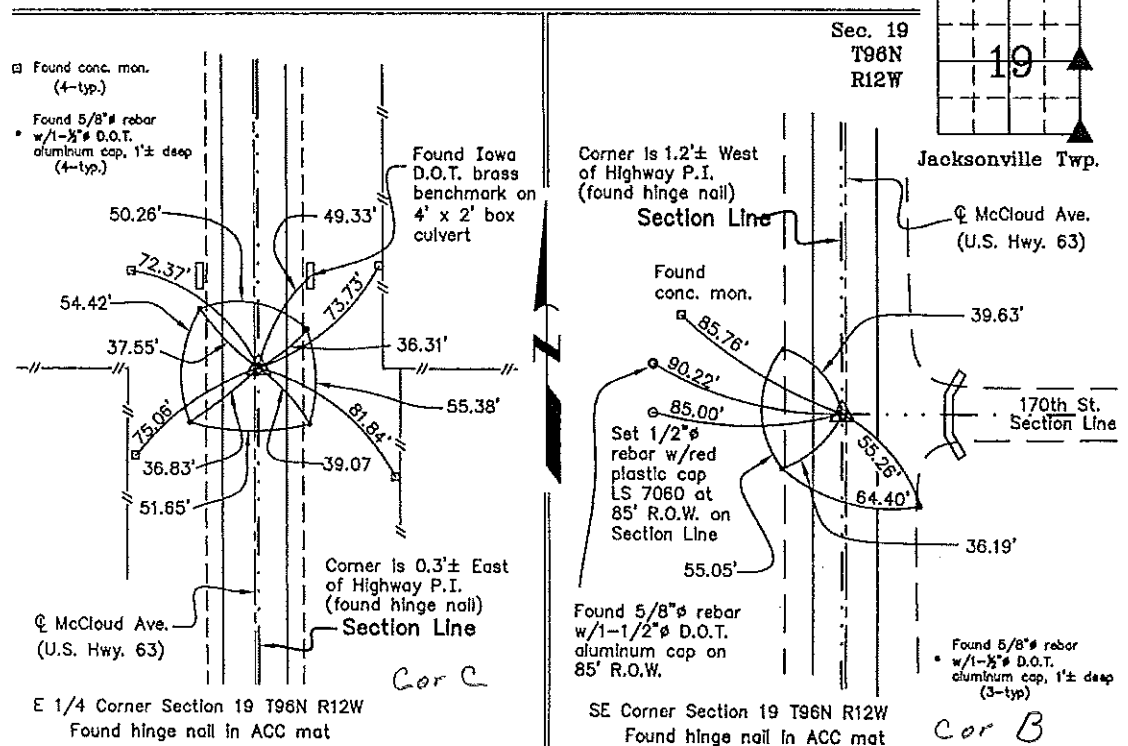

I hereby certify that this land surveying document was prepared and the related survey work was performed by me or under my direct personal supervision and that I am a duly licensed Land Surveyor under the laws of the State of Iowa.

Lyle G. TeKippe 3-26-01
Lyle G. TeKippe Date
License number 7060
My license renewal date is December 31, 2002.
Sheets covered by this seal: Individual

List Corners to be Indexed

Corners	Section	Twp.	Range
E 1/4	19	96N	12W
SE	19	96N	12W

2001-0544