

Instr. Number: 2023-1144  
 Recorded: 6/23/2023 at 11:19:59.0 AM  
 Pages 1  
 County Recording Fee: \$7.00  
 Iowa E-Filing Fee: \$3.00  
 Combined Fee: \$10.00  
 Revenue Tax:  
 Shirley Troyna RECORDER  
 Chickasaw County, Iowa

Prepared by & Return to: Kirk D. Reicks, HRS, L.L.C., 18 East Main Street, New Hampton, IA 50659, Phone 641-394-2725

### United States Public Land Survey Corner Certificate

Land Survey Monument situated in  
 Section 19, Township 96 North, Range 12 West of the Fifth Principal Meridian, Chickasaw County, Iowa.  
 On file in Document #2001-0544 in the County Recorder's Office.

This certificate is being prepared in compliance with Iowa Code Chapter 355.11 because: }


- There is no certificate on file for this corner.
- There are no longer three valid ties of record.
- There are changes to reference ties of record.
- There is change of monumentation of record.
- To clarify description of record monument (ties).

**Monument Description and Remarks:**


**Southeast Corner:** Found Survey Mark Nail w/Stainless Steel Washer IDOT with information obtained from the previously recorded Section Corner Certificate. Corner matches existing reference ties within reason.

### Plan View - Not to Scale

(Show a minimum of three reference ties to durable physical objects, relevant monuments and physical conditions that will enable recovery of the corner.)

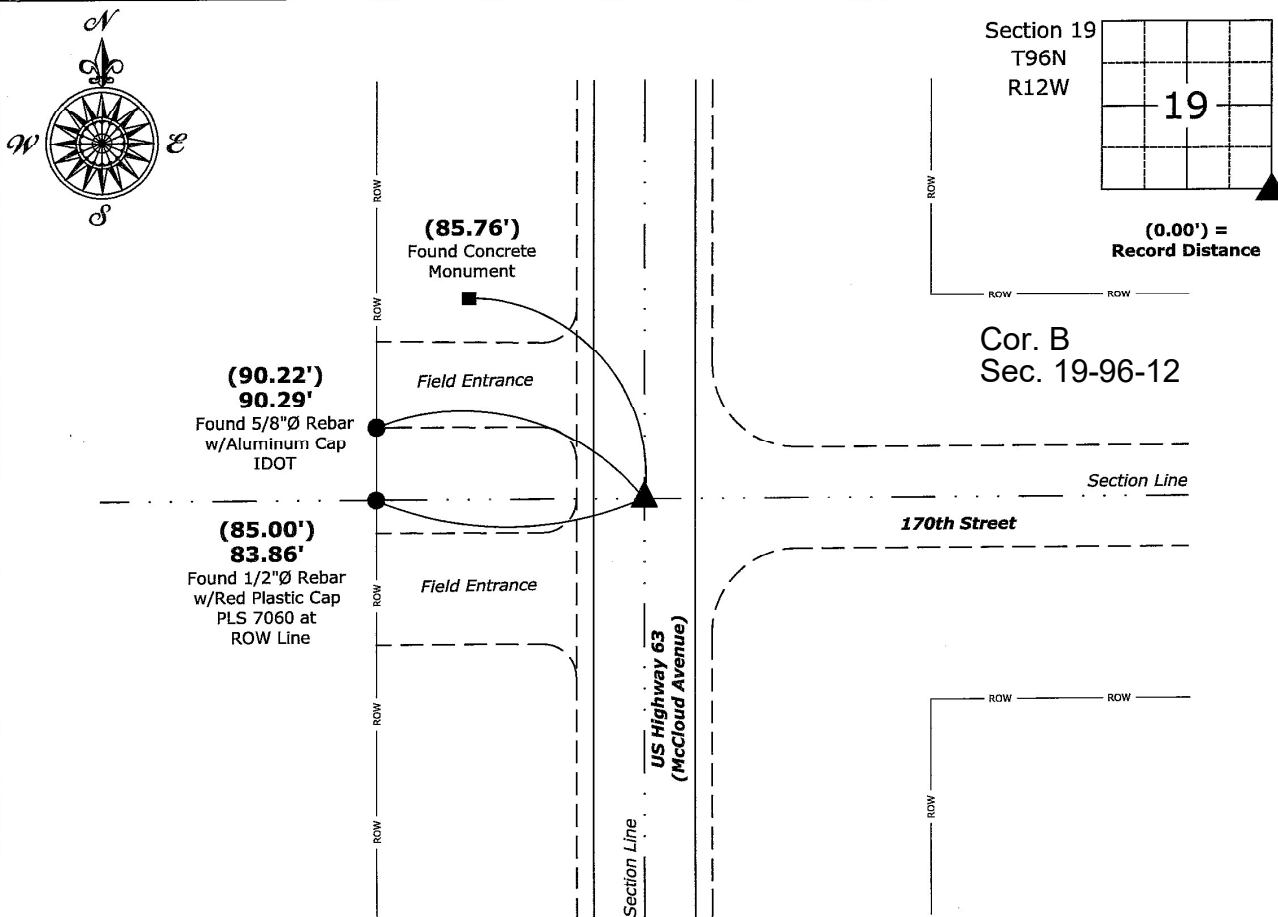

**Southeast Corner of Section 19-96-12**  
 Found Survey Mark Nail w/Stainless Steel Washer IDOT

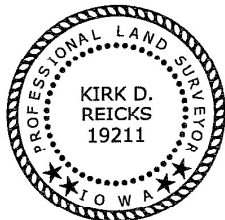

I hereby certify that this land surveying document was prepared and the related survey work was performed by me or under my direct personal supervision and that I am a duly licensed Land Surveyor under the laws of the State of Iowa.

*Kirk D. Reicks* 6-22-2023  
 Kirk D. Reicks Date:

License number 19211  
 My license renewal date is December 31, 2024.  
 Sheets covered by this seal: Individual sheet only

List Corner to be Indexed

Corner	Section	Township	Range
SE	19	96	12

Project Number: 2023-062

FB: Chickasaw 3, Page(s) 48, 65