

Chickasaw Co. Recorder
 Cindy Messersmith
Fee Book 2013-2144
 12/31/2013 @0331PM
 SCC SEC COR CERT Page: 1 # Pages: 1
 Book: Page: # Pages: 1
 Total Fees: \$7.00

Prepared by & Return to: Harold - Reicks Surveying, 13 East Main Street, New Hampton, IA 50659, Ph. 641-394-2725

UNITED STATES PUBLIC LAND SURVEY CORNER CERTIFICATE

Land Survey Monuments situated in Section 31, Township 96 North, Range 12 West of the Fifth Principal Meridian, Chickasaw County, Iowa. Not previously recorded in the County Recorder's office.

This certificate is being prepared in compliance with Iowa Code Chapter 355.11 because:



- There is no certificate on file for this corner.
- There are no longer three valid ties of record.
- There are changes to reference ties of record.
- There is change of monumentation of record.
- To clarify description of record monument (ties).

Monument Description and Remarks:

Center of Section: Set 5/8"Ø rebar w/2"Ø aluminum cap PLS 19211 0.30' West of an old wood fence corner post with information obtained from an IDOT Cornerstone Survey made by John D. Franklin, signed August 31, 1959 on file at the IDOT Office of Records, Ames, Iowa.

PLAN - VIEW

(Show a minimum of three reference ties to durable physical objects, relevant monuments and physical conditions that will enable recovery of the corner.)

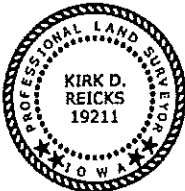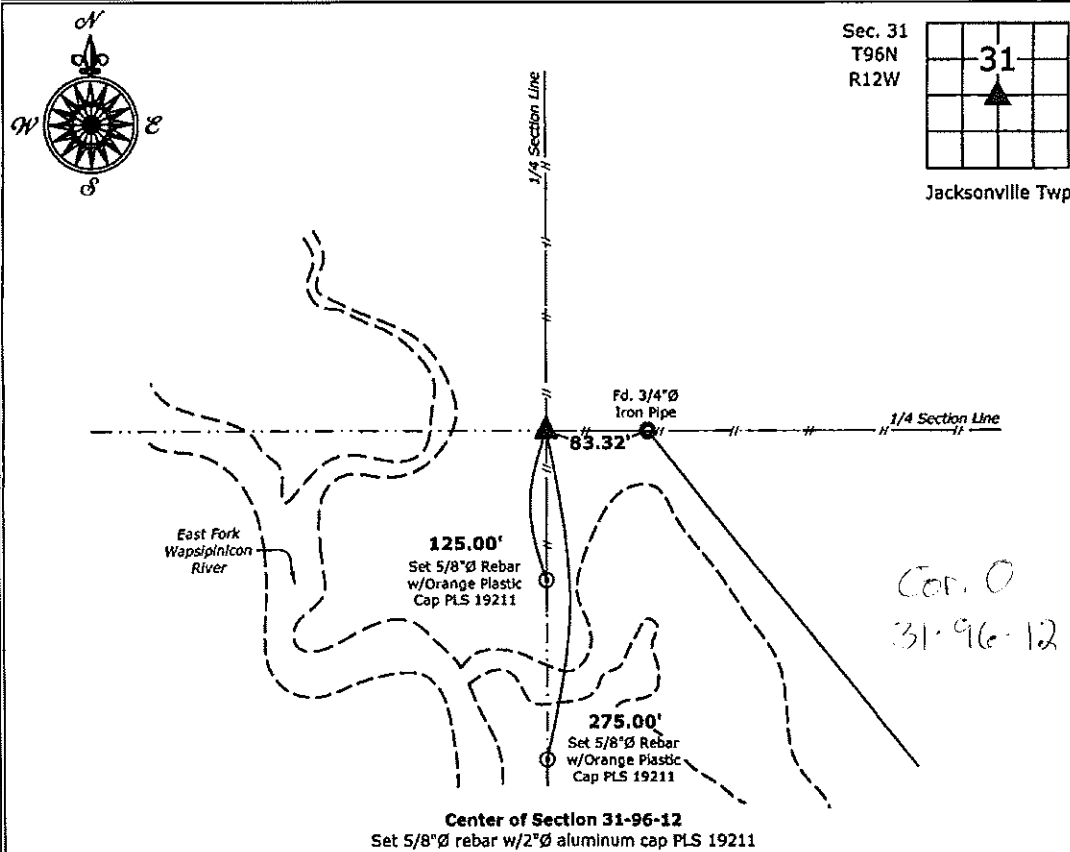

I hereby certify that this land surveying document was prepared and the related survey work was performed by me or under my direct personal supervision and that I am a duly licensed Land Surveyor under the laws of the State of Iowa.
Kirk D. Reicks 12-31-13
 Kirk D. Reicks Date:
 License number 19211
 My license renewal date is December 31, 2014.
 Sheets covered by this seal: Individual sheet only

List Corners to be Indexed			
Corners	Section	Twp.	Range
CTR	31	96	12
Project Number: 2013-178			
FB: Chickasaw 6, Pg. 10			

Fig. S-1_CSD Projects\2013\2013-178.dwg, 12/30/2013 2:58:45 PM