

FILED 2003 - 0591
 RECORDER'S OFFICE
 CHICKASAW COUNTY, IOWA
 2003 FEB 27 AM 8 37
 CINDY MESSERSMITH
 COUNTY RECORDER

TEKIPPE ENGINEERING, P.C., 128 South Vine Street, West Union, Iowa 52175 Phone (563) 422-5131

UNITED STATES PUBLIC LAND SURVEY CORNER CERTIFICATE

OF

Land Survey Monuments situated in Section 29, Township 96 North, Range 12 West of the Fifth Principal Meridian, CHICKASAW County, Iowa. Previously recorded in none in County Recorder's Office.
(book, page, document number, etc.)



(Show reason for preparing this certificate, the evidence and detailed procedures used in establishing the corner positions and monumentation found or placed.)

Monument Description and Remarks: S 1/4 Corner Section 29 T96N R12W: Found 5/8" pipe w/aluminum cap 2886 with information obtained from a Survey and Plat made by L. P. Erdman recorded in the Chickasaw County Recorder's Office January 23, 1998 in Deeds Book 123, Pages 274-275.

PLAN - VIEW

Project Number 03026.LS
 FB. 46J PG. 69-81

(Show a minimum of three reference ties to durable physical objects, relevant monuments and physical conditions that will enable recovery of the corner.)

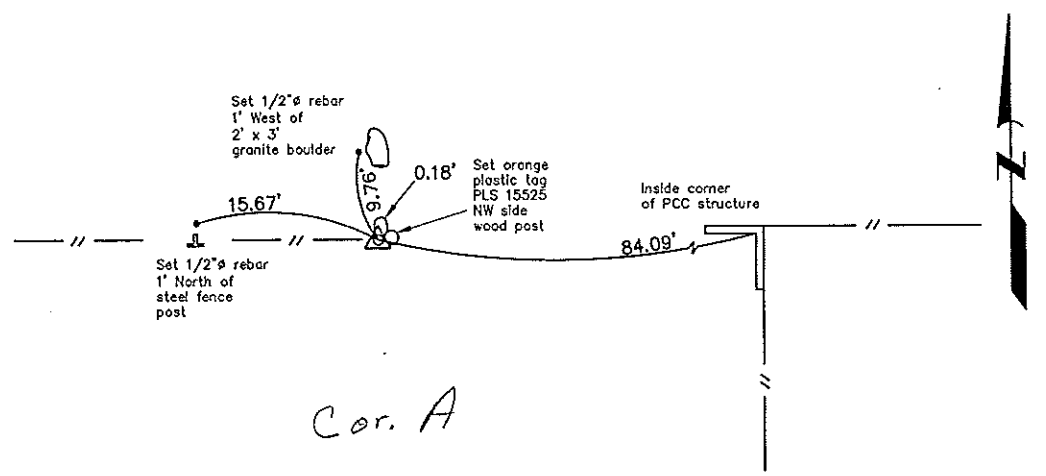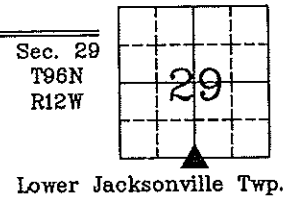

S 1/4 Corner Section 29 T96N R12W
 Found 5/8" pipe w/aluminum cap 2886



I hereby certify that this land surveying document was prepared and the related survey work was performed by me or under my direct personal supervision and that I am a duly licensed Land Surveyor under the laws of the State of Iowa.
Paul R. Herold 2-26-03
 Paul R. Herold Date
 License number 15525
 My license renewal date is December 31, 2004.
 Sheets covered by this seal: Individual

List Corners to be Indexed			
Corners	Section	Twp.	Range
S 1/4	29	96N	12W
Filed 2-28-03			

X:\Section Corners\Sec. 29\29-96-12w.dwg

County Engineer's Office