

UNITED STATES PUBLIC LAND SURVEY CORNER CERTIFICATE


SECTION 3 , TOWNSHIP 96 , RANGE 12 OF THE 5TH. P.M.
 IN CHICKASAW COUNTY, IOWA

CORNER: NE COR NW1/4 NW1/4

DESCRIPTION AND REMARKS:

SET #5 REBAR W/CAP

PREVIOUSLY RECORDED IN BOOK _____, PAGE _____

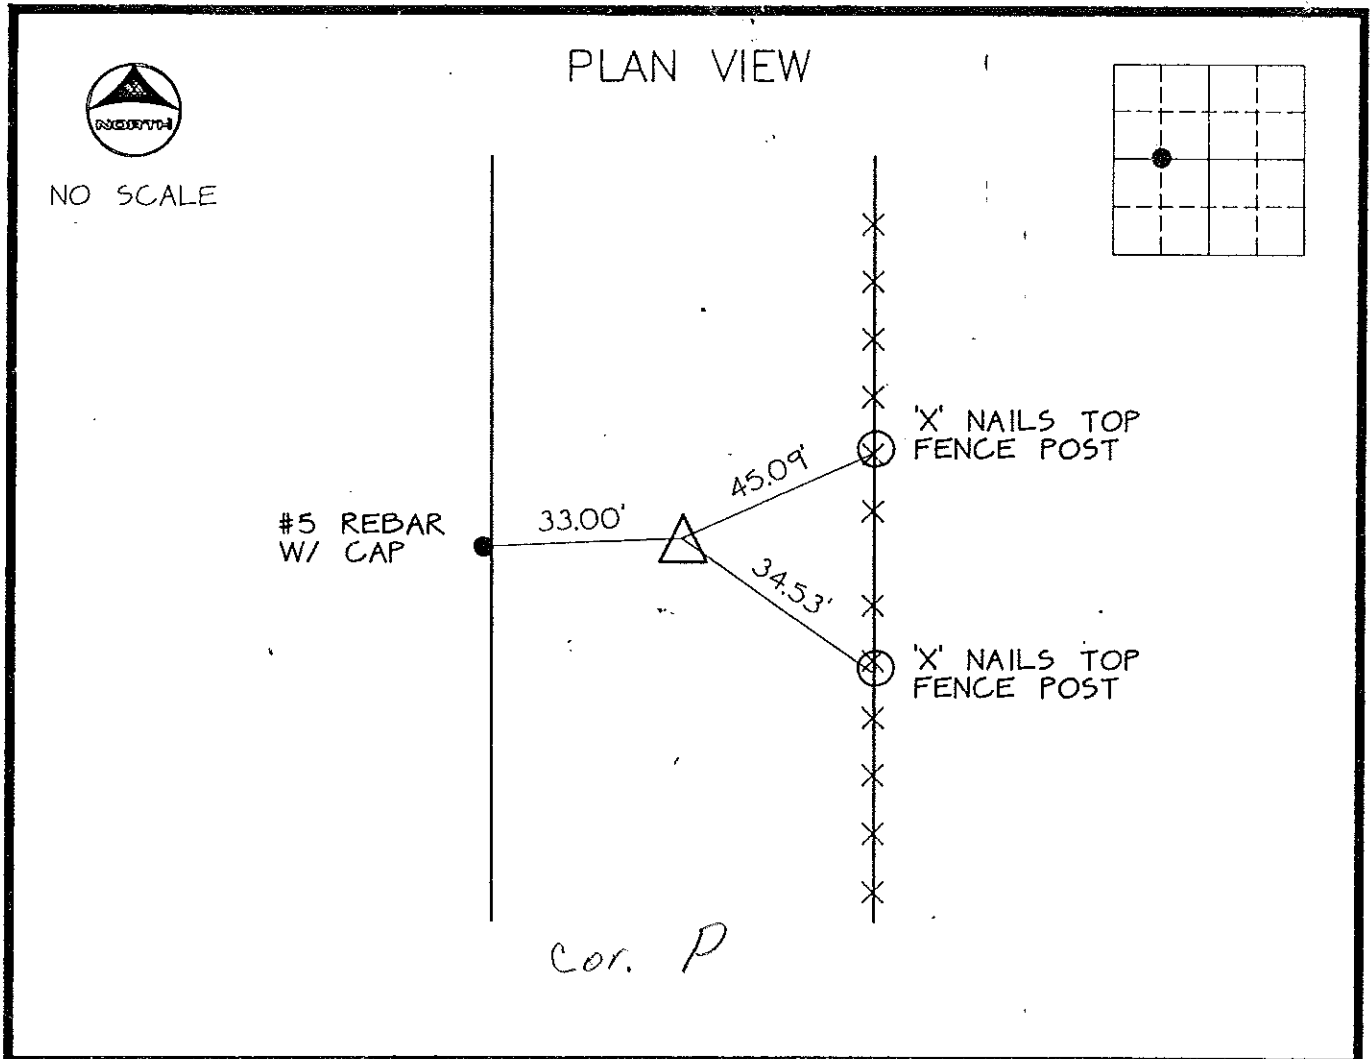

CERTIFICATION:
 I HEREBY CERTIFY THAT THIS MAP, PLAT, OR SURVEY WAS MADE BY ME OR UNDER MY DIRECT PERSONAL SUPERVISION AND THAT I AM A DULY REGISTERED LAND SURVEYOR UNDER THE LAWS OF THE STATE OF IOWA.

Thomas V. Craft DATE: 07/08/91
 THOMAS V. CRAFT REG. L.S. NO. 7549

MCN/214150

INDEXING ALTERNATIVES			
CORNER	SECTION	TWP	RANGE