

UNITED STATES PUBLIC LAND SURVEY CORNER CERTIFICATE

OF

Land Survey Monuments situated in Section 4, Township 96 North, Range 12 West, of the Fifth Principal Meridian, Chickasaw County, Iowa. Previously recorded in Book 147, Pages 469 & 470, Deeds in County Recorder's Office.
(book, page, document number, etc.)


(Show reason for preparing this certificate, the evidence and detailed procedures used in establishing the corner positions and monumentation found or placed.)

Monument Description and Remarks: North Quarter Corner 4-96-12: Set Rebar w/Cap from Ties shown in Book 147, Page 469, Deeds.

Center 4-96-12: Set Rebar w/Cap at Intersection of Quarter Corners and matching Tie shown in Book 147, Page 470, Deeds.

PLAN - VIEW

(Show a minimum of three reference ties to durable physical objects, relevant monuments and physical conditions that will enable recovery of the corner.)

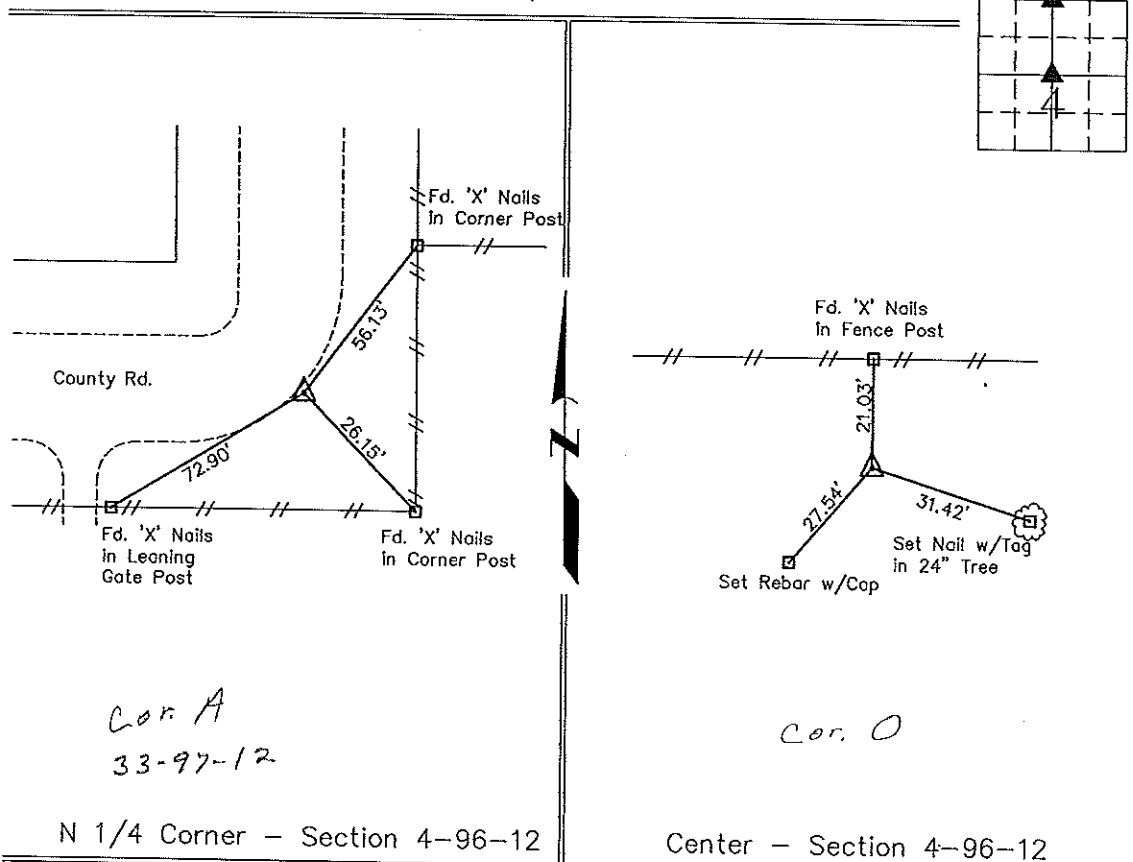

I hereby certify that this land surveying document was prepared and the related survey work was performed by me or under my direct personal supervision and that I am a duly licensed Land Surveyor under the laws of the State of Iowa.

Lyle G. TeKippe 3-24-97
 Lyle G. TeKippe Date
 License number 7060
 My license renewal date is December 31, 1998.
 Sheets covered by this seal: Individual

List Corners to be Indexed			
Corners	Section	Twp.	Range
N 1/4	4	96	12
Center	4	96	12
<i>Corner 0-496-12</i>			

Placed in tie book. 3/27/97

UNITED STATES PUBLIC LAND SURVEY CORNER CERTIFICATE


SECTION 4 , TOWNSHIP 96 , RANGE 12 OF THE 5TH. P.M.
 IN CHICKASAW COUNTY, IOWA

CORNER: CENTER

DESCRIPTION AND REMARKS:

SET #5 REBAR W/ CAP ON LINE
 BETWEEN E 4 - W 4 & N 4 - S 4 CORNER

PREVIOUSLY RECORDED IN BOOK _____, PAGE _____

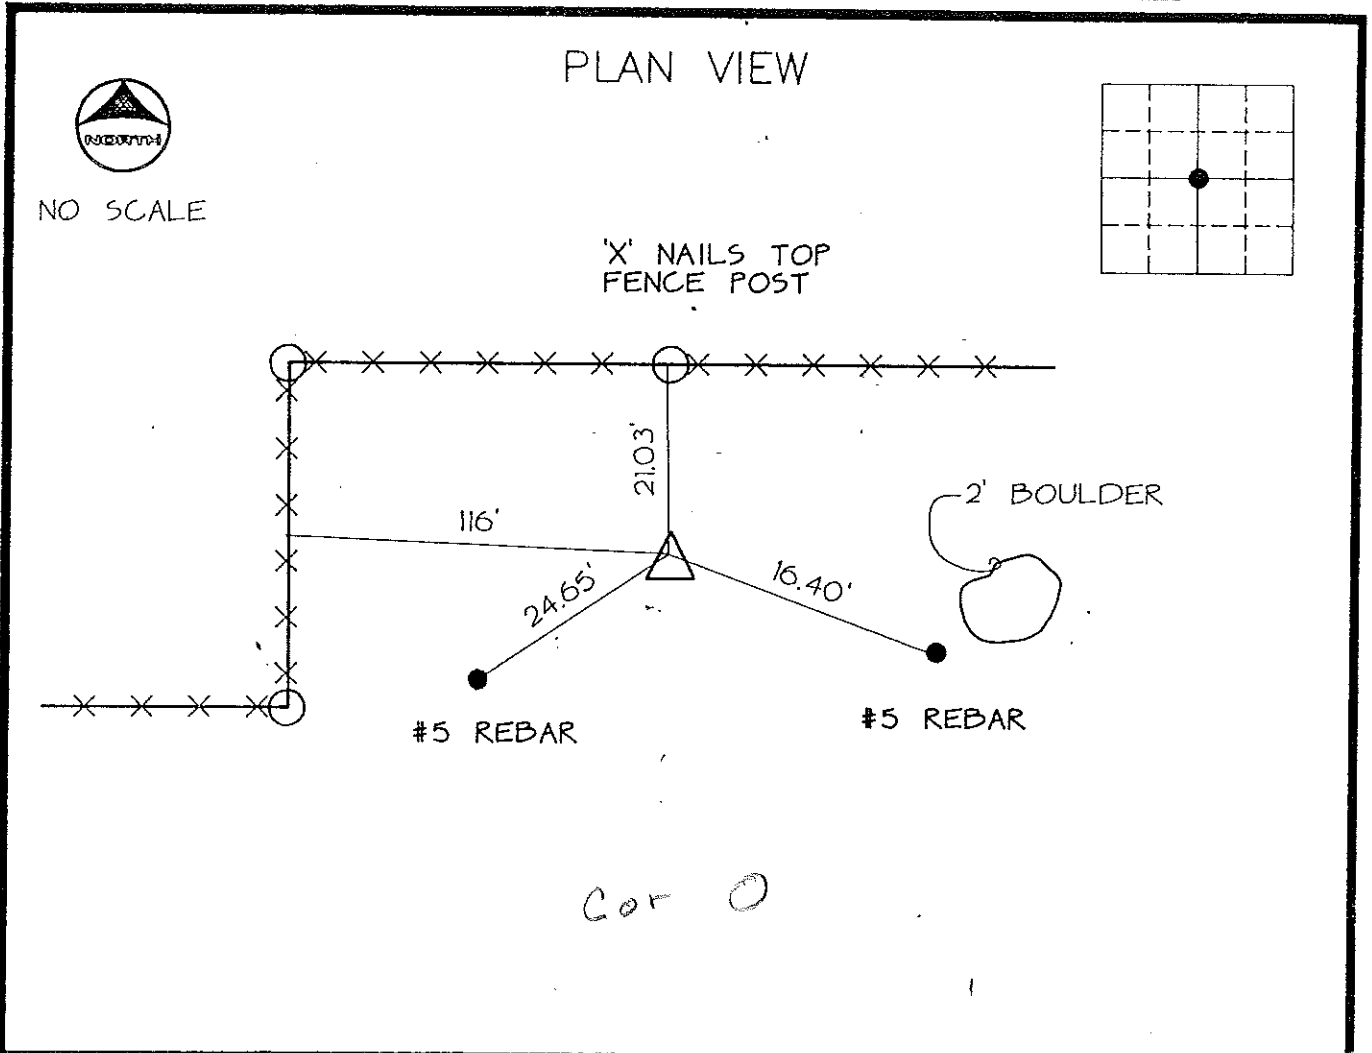

CERTIFICATION:
 I HEREBY CERTIFY THAT THIS MAP, PLAN, OR SURVEY WAS MADE BY
 ME OR UNDER MY DIRECT PERSONAL SUPERVISION AND THAT I AM A
 DULY REGISTERED LAND SURVEYOR UNDER THE LAWS OF THE STATE
 OF IOWA.

Thomas V. Craft DATE: 07/08/91
 THOMAS V. CRAFT REG. L.S. NO. 7849

MCN/214150

INDEXING ALTERNATIVES			
CORNER	SECTION	TWP	RANGE