

UNITED STATES PUBLIC LAND SURVEY CORNER CERTIFICATE


SECTION 5 , TOWNSHIP 96 , RANGE 12 OF THE 5TH. P.M.
 IN CHICKASAW COUNTY, IOWA

CORNER: E1/4

DESCRIPTION AND REMARKS:

FOUND STONE
 SET 'X' ON HIGH
 POINT

PREVIOUSLY RECORDED IN BOOK _____, PAGE _____

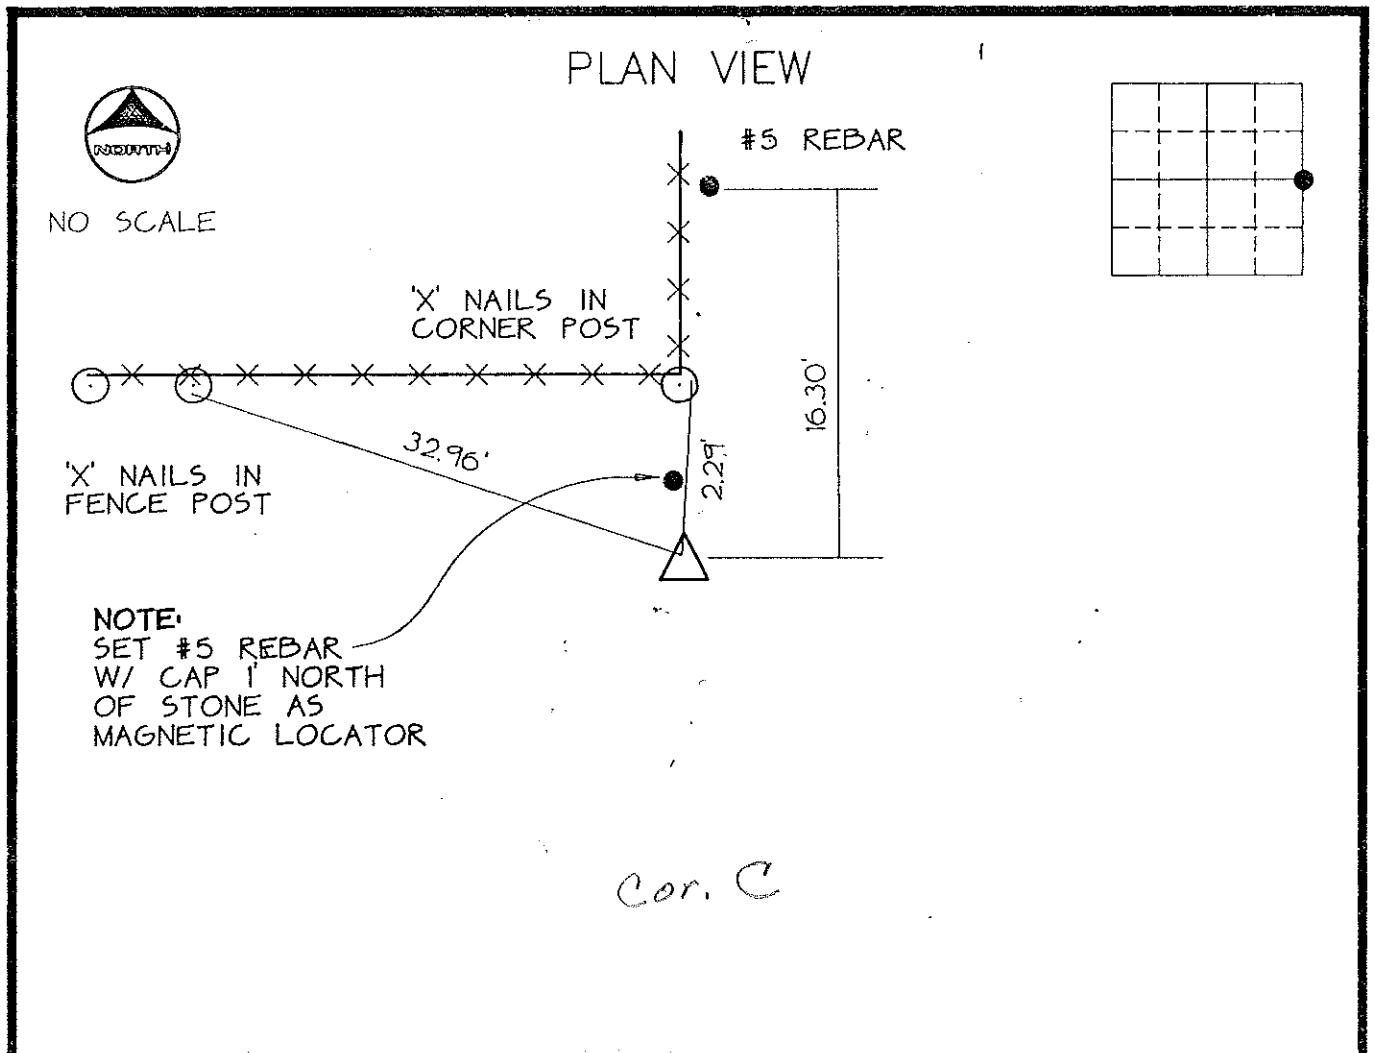

CERTIFICATION:
 I HEREBY CERTIFY THAT THIS MAP, PLAN, OR SURVEY WAS MADE BY
 ME OR UNDER MY DIRECT PERSONAL SUPERVISION AND THAT I AM A
 DULY REGISTERED LAND SURVEYOR UNDER THE LAWS OF THE STATE
 OF IOWA.

Thomas V. Craft
 THOMAS V. CRAFT REG. L.S. NO. 7549

DATE: 07/08/91



MCN/214150

INDEXING ALTERNATIVES

CORNER	SECTION	TWP	RANGE
--------	---------	-----	-------

W1/4	4	96	12
------	---	----	----