

Prepared by & Return to Herold - Reicks Surveying, 10 East Main Street, New Hampton, IA 50659, Ph. 641-394-2725

UNITED STATES PUBLIC LAND SURVEY CORNER CERTIFICATE

Land Survey Monuments situated in Section 6, Township 96 North, Range 12 West of the Fifth Principal Meridian, Chickasaw County, Iowa. Corner was not previously recorded in the County Recorder's office.

This certificate is being prepared in compliance with Iowa Code Chapter 355.11 because:


- There is no certificate on file for this corner.
- There are no longer three valid ties of record.
- There are changes to reference ties of record.
- There is change of monumentation of record.
- To clarify description of record monument (ties).

Monument Description and Remarks:

Southwest Corner SE 1/4-SW 1/4: Set 5/8"Ø rebar w/2"Ø aluminum cap PLS 15525 by single proportionate method utilizing dimensions found on original Government Plat.

PLAN - VIEW

(Show a minimum of three reference ties to durable physical objects, relevant monuments and physical conditions that will enable recovery of the corner.)

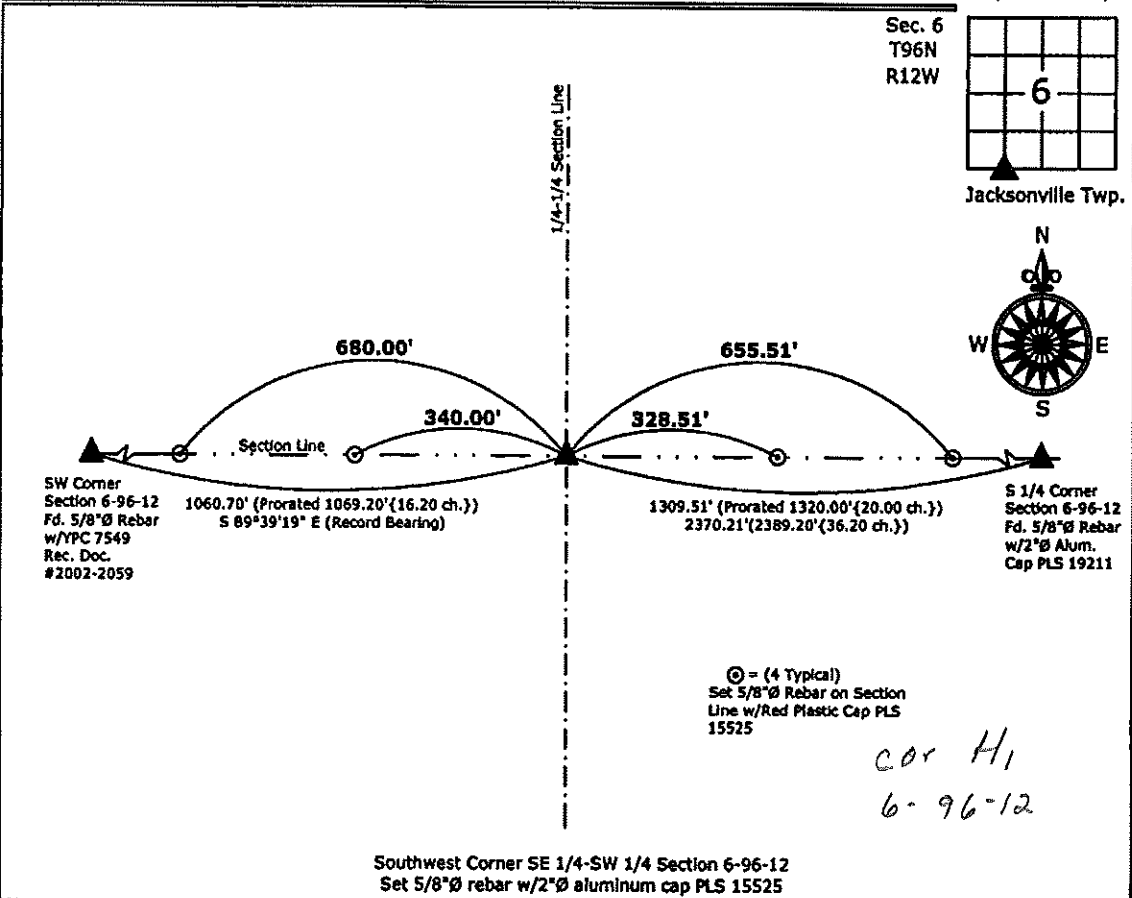

I hereby certify that this land surveying document was prepared and the related survey work was performed by me or under my direct personal supervision and that I am a duly licensed Land Surveyor under the laws of the State of Iowa.

Paul R. Herold 1-12-12
 Paul R. Herold Date:
 License number 15525
 My license renewal date is December 31, 2012.
 Sheets covered by this seal: Individual sheet only

| List Corners to be Indexed | | | |
|--------------------------------|---------|------|-------|
| Corners | Section | Twp. | Range |
| SW-SE-SW | 6 | 96 | 12 |
| Project Number: 2011-154 | | | |
| FB: Chickasaw County 2, Pg. 74 | | | |

File: S:_CSD Projects\2011-154\2011-154.dwg, 1/10/2012 3:00:04 PM