

Instrument #: 2022-1870
 10/14/2022 03:34:21 PM Total Pages: 1
 SCC SECTION CORNER CERTIFICATES
 Recording Fee: \$ 7.00
 Shirley Troyna, Recorder, Chickasaw County Iowa



Prepared by: Kyle A. Johnson Address: 1900 MEDICAL ARTS AVE S, SUITE 100 SARTELL, MN Phone: 1-888-937-5150

UNITED STATES PUBLIC LAND SURVEY CORNER CERTIFICATE FOR

Land survey monuments situated in Section 10, Township 96 NORTH

Range 12 WEST, of the Fifth Principal Meridian, CHICKASAW County, Iowa.

Previously Recorded in _____ in County Recorder's Office.

(Show reason for preparing this certificate, the evidence and detailed procedures used in establishing the corner positions and monumentation found or placed.)


MONUMENT DESCRIPTION AND REMARKS:

WEST QUARTER: Westwood Professional Services found a 1/2" rebar 0.6' deep near N/S road centerline and fence line west. Accepting corner location and set 3 ties. Filing corner location as there are no longer 3 valid ties of record.


SOUTH QUARTER: Westwood Professional Services found a 1/2" square bar 0.2' deep 7' south of centerline that agrees with field lines north and south. Accepting corner location as best available evidence. Filing corner record as there is no certificate on file for this corner.

PLAN - VIEW

(Show a minimum of three reference ties to durable physical objects, relevant monuments and physical conditions that will enable recovery of the corner.)

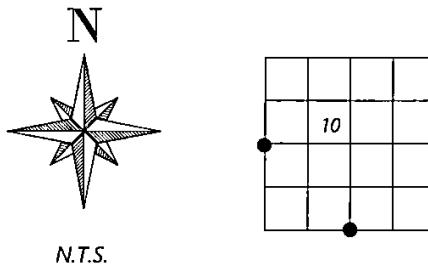

Cor. C 9-96-12

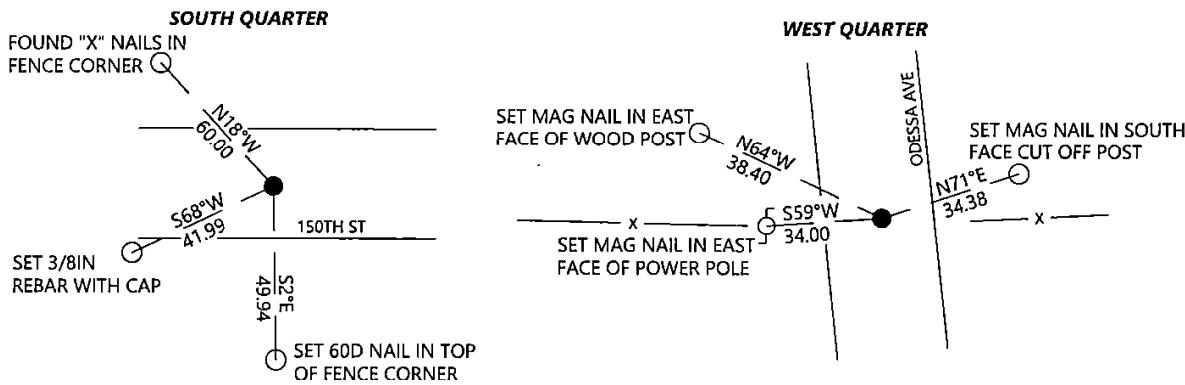

SEAL 	<p>I hereby certify that this land surveying document was prepared and the related survey work was performed by me or under my direct personal supervision and that I am a duly licensed Land Surveyor under the laws of the state of Iowa.</p> <p><u>Kyle Johnson</u> <u>10/14/2022</u> <small>Signature Date</small></p> <p>Typed/Printed Name: <u>Kyle A. Johnson</u></p> <p>License Number: <u>25725</u></p> <p>My license renewal date is December 31, <u>2022</u></p> <p>Pages or sheets covered by this seal: <u>THIS SHEET</u></p>	<p>Corners to be indexed</p> <table border="1"> <thead> <tr> <th>Corners</th> <th>Section</th> <th>Twp.</th> <th>Range</th> </tr> </thead> <tbody> <tr> <td>WQ</td> <td>10</td> <td>96</td> <td>12</td> </tr> <tr> <td>SQ</td> <td>10</td> <td>96</td> <td>12</td> </tr> </tbody> </table>	Corners	Section	Twp.	Range	WQ	10	96	12	SQ	10	96	12
Corners	Section	Twp.	Range											
WQ	10	96	12											
SQ	10	96	12											