

Instr. Number: 2021-0242
 Recorded: 2/3/2021 at 10:39:56.0 AM
 Pages 1
 County Recording Fee: \$7.00
 Iowa E-Filing Fee: \$3.00
 Combined Fee: \$10.00
 Revenue Tax:
 Shirley Troyna RECORDER
 Chickasaw County, Iowa

PREPARED BY / RETURN TO: MIRANDA K. EILDERS IOWA DEPARTMENT OF TRANSPORTATION 420 43rd ST. SW MASON CITY, IA 50401 641-423-7584

UNITED STATES PUBLIC LAND SURVEY CORNER CERTIFICATE

OF

Land Survey Monuments situated in Section 20, Township 97N, Range 12W
 of the Fifth Principal Meridian, CHICKASAW County, Iowa.


Previously recorded in DOC. NO. 2007-1591 in County Recorder's Office.
(book, page, document number, etc.)

(Show reason for preparing this certificate, the evidence and detailed procedures used in establishing the corner positions and monumentation found or placed.)

Monument Description and Remarks: NW CORNER REPLACED PREVIOUSLY FOUND MAG NAIL/WASHER
*15525 WITH MAG SPIKE/IDOT WASHER *22293 1.8" WEST C US 63 PER PREVIOUS CERT OF RECORD
DOC. NO. 2007-1591 AFTER RESURFACING PROJECT NHSX-063-9(26)--3H-45.
REASON FOR CERT: MONUMENTATION AND TIES HAS CHANGED.

PLAN - VIEW

(Show a minimum of three reference ties to durable physical objects, relevant monuments and physical conditions that will enable recovery of the corner.)

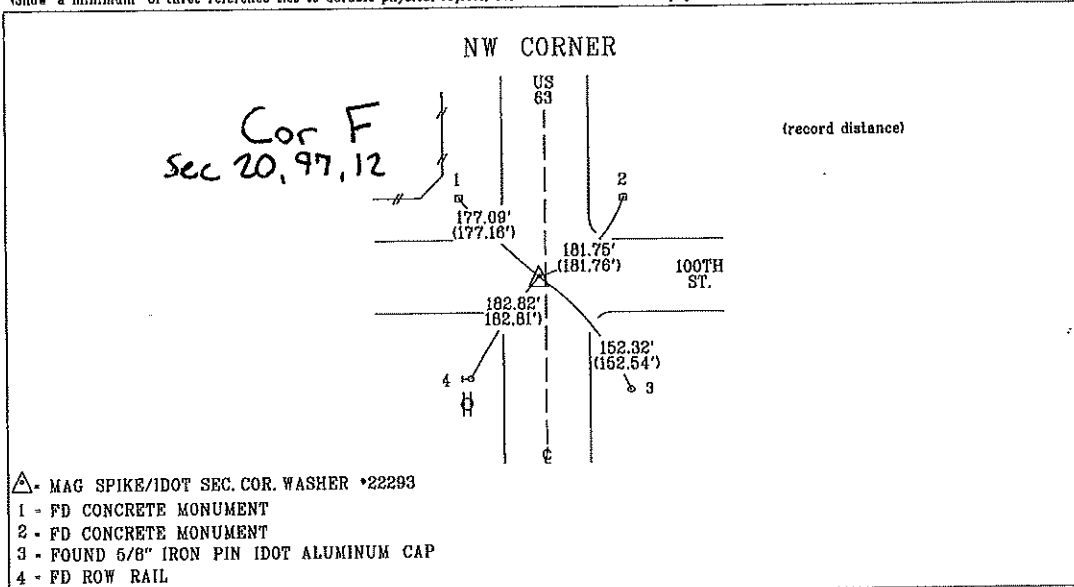

- △ - MAG SPIKE/IDOT SEC. COR. WASHER *22293
- 1 - FD CONCRETE MONUMENT
- 2 - FD CONCRETE MONUMENT
- 3 - FOUND 5/8" IRON PIN IDOT ALUMINUM CAP
- 4 - FD ROW RAIL

List Corners to be Indexed
 Corner Section Township Range

NW CORNER 20 97N 12W



I hereby certify that this land surveying document was prepared and the related survey work was performed by me or under my personal supervision and that I am duly licensed professional Land Surveyor under the laws of the state of Iowa.
Miranda K. Eilders 2-1-2021
 Miranda K. Eilders Date
 License number 22293
 My license renewal date is December 31, 2021
 Pages or sheets covered by this seal. 1

