

FILED 2003-0909
RECORDER'S OFFICE
CHICKASAW COUNTY, IOWA
2003 MAR 27 ^{fee 6.00} AM 9 17
CINDY MESSERSMITH
COUNTY RECORDER

Corner B:
Section 23-97-12
As referred to in
Engr The Book

Lampman & Associates Robert M. Lampman E750 Roberts Rd. De Soto, Wisconsin 54624 (608)648-2288

UNITED STATES PUBLIC LAND SURVEY CORNER CERTIFICATE

23 OF

Land Survey Monuments situated in Section 24, Township 97 North, Range 12 West,
of the Fifth Principal Meridian, Chickasaw County, Iowa.
Previously recorded in no certificate on file in County Recorder's Office.
(book, page, document number, etc.)


(Show reason for preparing this certificate, the evidence and detailed procedures used in establishing the corner positions and monumentation found or placed.)

Monument Description and Remarks:

Reestablished corner location utilizing reference ties of record from the Chickasaw County Engineer's Office.
Set a 1/2" round iron rod at the corner location.

PLAN VIEW

(Show a minimum of three reference ties to durable physical objects, relevant monuments and physical conditions that will enable recovery of the corner.)

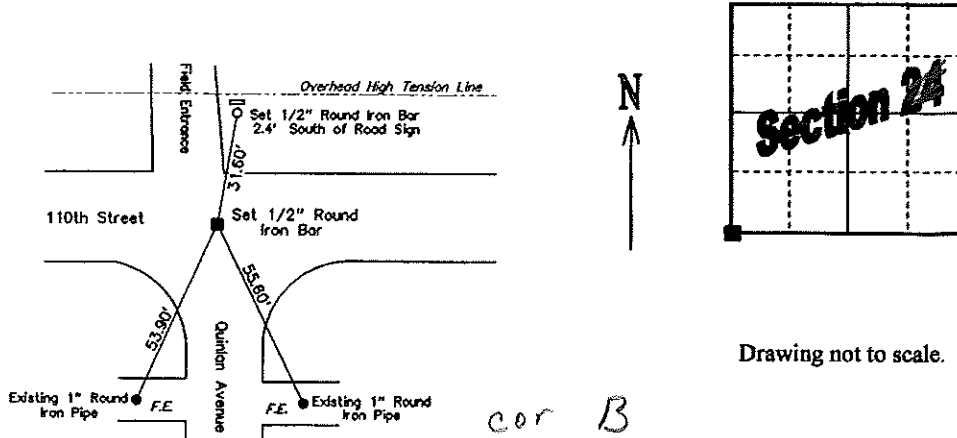


cor B
23-97-12

I hereby certify that the survey work was completed and this certificate was prepared by me or under my direct personal supervision and that I am a duly licensed land surveyor under the laws of the state of Iowa.

Signature: Robert M. Lampman
Robert M. Lampman

Date: 3-10-03 License No. 10317

My License Renewal Date Is: 12-31-04

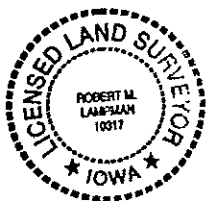

SEAL

Corners	List Corners to Be Indexed		
	Section	Twp	Range
SW COR	24	97 North	12 West