

Prepared by & Return to Herold - Reicks Surveying, 18 East Main Street, New Hampton, IA 50658, Ph. 641-354-2725

### UNITED STATES PUBLIC LAND SURVEY CORNER CERTIFICATE

Land Survey Monuments situated in Section 21, Township 97 North, Range 12 West of the Fifth Principal Meridian, Chickasaw County, Iowa. Not previously recorded in the County Recorder's office.

This certificate is being prepared in compliance with Iowa Code Chapter 355.11 because:


- There is no certificate on file for this corner.
- There are no longer three valid ties of record.
- There are changes to reference ties of record.
- There is change of monumentation of record.
- To clarify description of record monument (ties).

Monument Description and Remarks:

**Southeast Corner SW 1/4-SW 1/4:** Set 5/8"Ø rebar w/2"Ø aluminum cap PLS 15525 equidistant jand online between the Southwest and South 1/4 Corner of Section 21.

#### PLAN - VIEW

(Show a minimum of three reference ties to durable physical objects, relevant monuments and physical conditions that will enable recovery of the corner.)

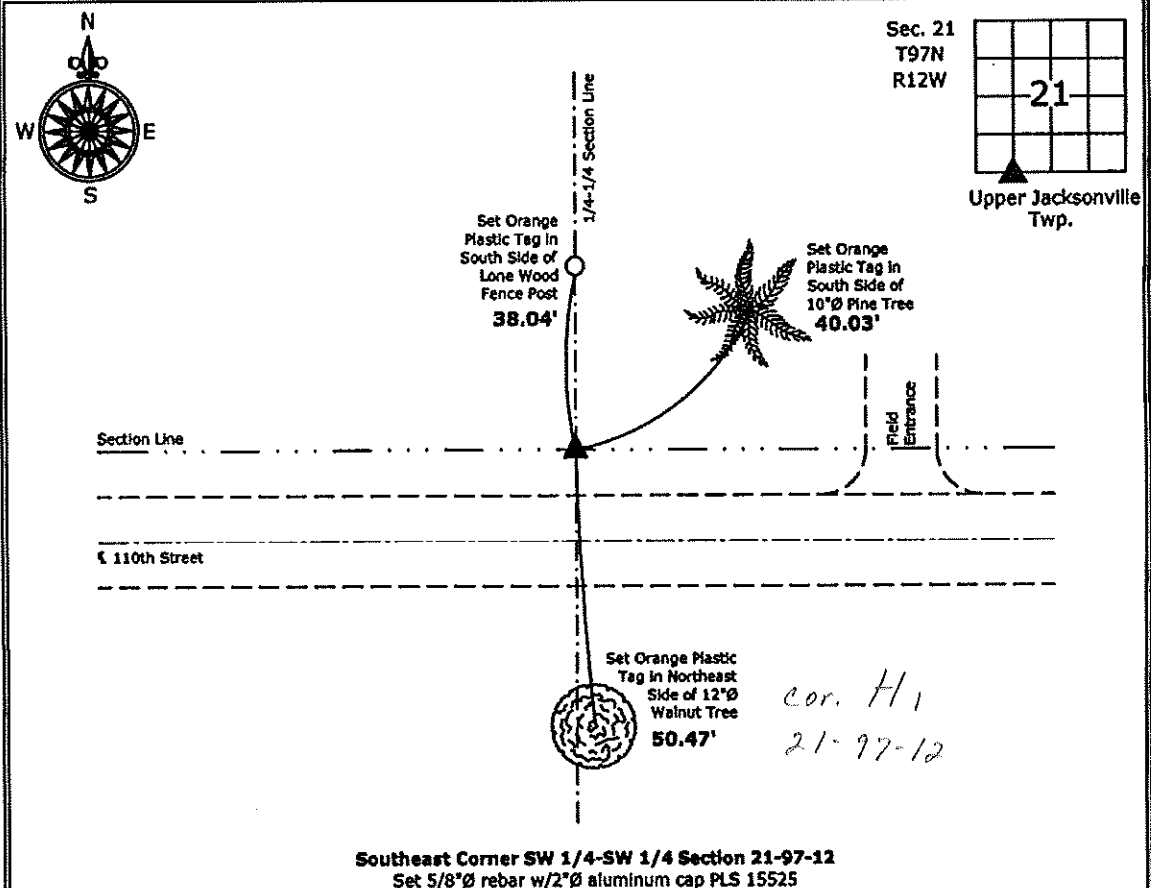

**Southeast Corner SW 1/4-SW 1/4 Section 21-97-12**  
 Set 5/8"Ø rebar w/2"Ø aluminum cap PLS 15525



I hereby certify that this land surveying document was prepared and the related survey work was performed by me or under my direct personal supervision and that I am a duly licensed Land Surveyor under the laws of the State of Iowa.

*Paul R. Herold 2/16-12*  
 Paul R. Herold Date:  
 License number 15525  
 My license renewal date is December 31, 2012.  
 Sheets covered by this seal: Individual sheet only

| List Corners to be Indexed     |         |      |       |
|--------------------------------|---------|------|-------|
| Corners                        | Section | Twp. | Range |
| SE-SW-SW                       | 21      | 97   | 12    |
| Project Number: 2011-175       |         |      |       |
| FB: Chickasaw County 2, Pg. 32 |         |      |       |