

Chickasaw Co. Recorder  
 Cindy Messersmith  
**Fee Book 2008-0083**  
 01/11/2008 @0407PM  
 SCC SEC COR CERT # Pages: 1  
 Book: Page: \$7.00  
 Total Fees:

Corner A + B!  
 Section 30-97-12  
 As referred to in  
 Engr. Tie Book

Herold - Recks Surveying, 25 1/2 East Main Street, Suite 204, New Hampton, IA 50659, Ph. 641-394-2725

**UNITED STATES PUBLIC LAND SURVEY CORNER CERTIFICATE**

Land Survey Monuments situated in:  
 Section 31, Township 97 North, Range 12 West of the Fifth Principal Meridian,  
Chickasaw County, Iowa. Previously recorded in (1.) Doc. #2001-1866 2.) Bk. 173, Pg. 50  
 in County Recorder's Office. (book, page, document number, etc.)


(Show reason for preparing this certificate, the evidence and detailed procedures used in establishing the corner positions and monumentation found or placed.)

**Monument Description and Remarks:**

- 1.) N 1/4 Corner Section 31-97-12: Fd. 1/2"Ø rebar w/1-1/2"Ø aluminum cap PLS 11442 over top of previously tied 1/2" X 1-1/2" flat iron bar (sleigh runner). All previous ties exist. Certificate is being prepared to indicate change in monumentation.
- 2.) NE Corner Section 31-97-12: Fd. survey nail w/washer stamped "IDOT". Previous corner (hingè nail) was covered over by an HMA resurfacing project in the summer of 2007.

**PLAN - VIEW**

(Show a minimum of three reference ties to durable physical objects, relevant monuments and physical conditions that will enable recovery of the corner.)

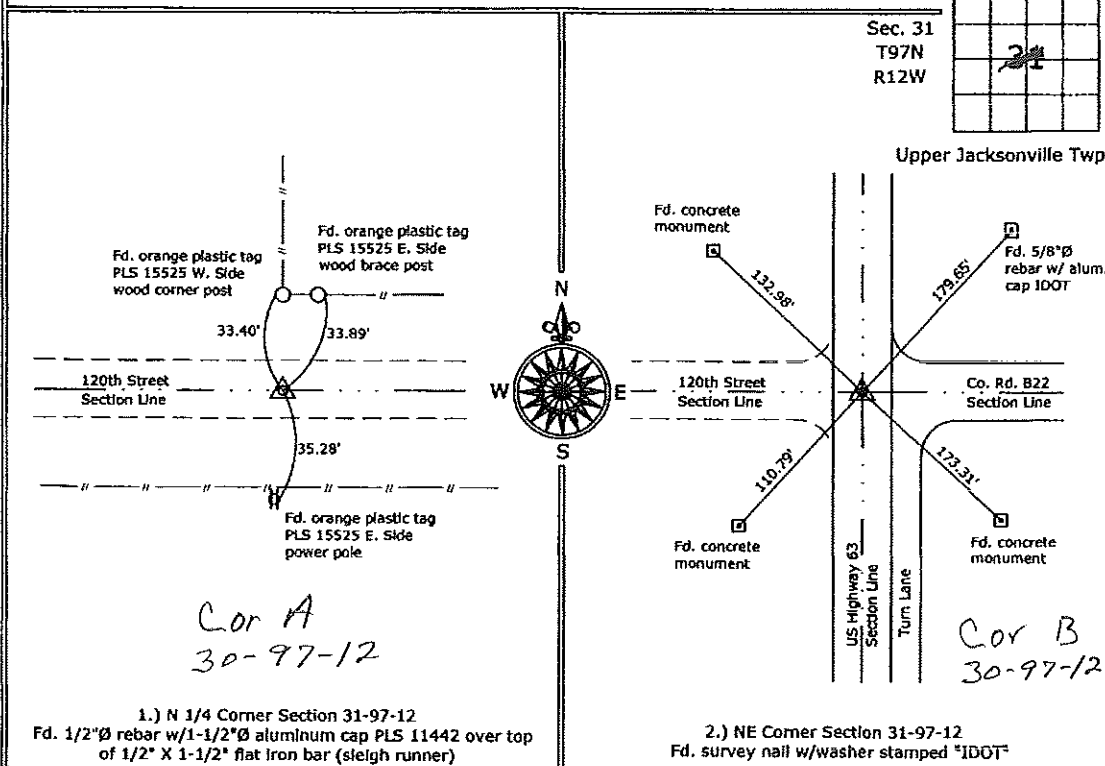

Cor A  
 30-97-12

Cor B  
 30-97-12

1.) N 1/4 Corner Section 31-97-12  
 Fd. 1/2"Ø rebar w/1-1/2"Ø aluminum cap PLS 11442 over top of 1/2" X 1-1/2" flat iron bar (sleigh runner)

2.) NE Corner Section 31-97-12  
 Fd. survey nail w/washer stamped "IDOT"



I hereby certify that this land surveying document was prepared and the related survey work was performed by me or under my direct personal supervision and that I am a duly licensed Land Surveyor under the laws of the State of Iowa.

*Paul R. Herold* 1-11-08  
 Paul R. Herold Date:  
 License number 15525  
 My license renewal date is December 31, 2008.  
 Sheets covered by this seal: Individual sheet only

List Corners to be Indexed			
Corners	Section	Twp.	Range
N 1/4	31	97	12
NE	31	97	12

Project Number: 2007-127  
 FB: Chickasaw County 1, Pgs. 45-46

File: S:\\_Projects\2007-127\dwg\2007-127.dwg, 1/10/2008 9:57:44 AM