

Prepared by & Return to: Herold - Reicks Surveying, 10 East Main Street, New Hampton, IA 50659, Ph. 641-394-3725

UNITED STATES PUBLIC LAND SURVEY CORNER CERTIFICATE

Land Survey Monuments situated in Section 35, Township 97 North, Range 12 West of the Fifth Principal Meridian, Chickasaw County, Iowa. 1., 2.) Not previously recorded in the County Recorder's office.

This certificate is being prepared in compliance with Iowa Code Chapter 355.11 because:


- 1 & 2 There is no certificate on file for this corner.
 There are no longer three valid ties of record.
 There are changes to reference ties of record.
 There is change of monumentation of record.
 To clarify description of record monument (ties).

Monument Description and Remarks:


- 1.) **Center of Section:** Set 5/8"Ø rebar with 2"Ø aluminum cap PLS 15525 at the intersection of the North-South Quarter Section Line and the a possession line fence from the West.
- 2.) **Southeast Corner SW 1/4 - NE 1/4 Corner:** Set 5/8"Ø rebar with 2"Ø aluminum Cap PLS 15525 equidistant and online between the East 1/4 Corner and Center of Section 35.

PLAN - VIEW

(Show a minimum of three reference ties to durable physical objects, relevant monuments and physical conditions that will enable recovery of the corner.)

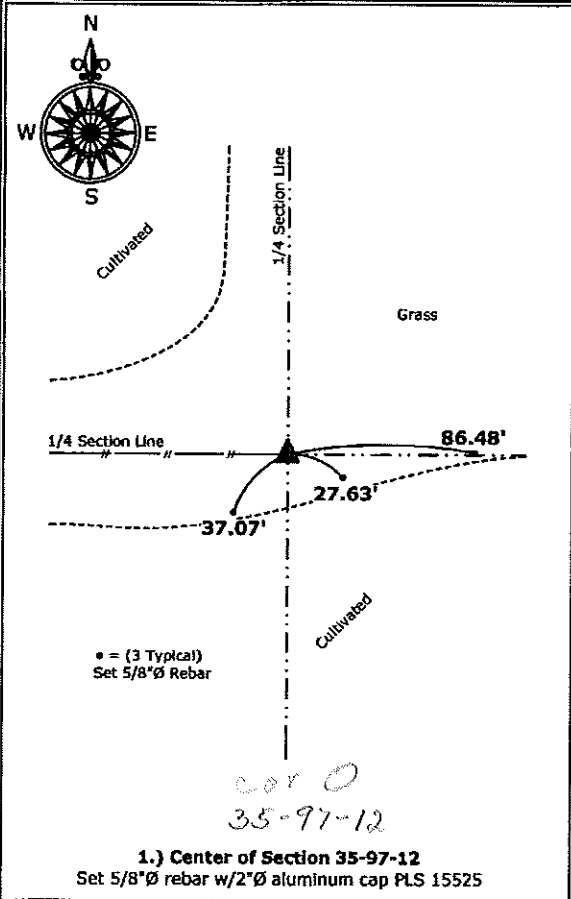

1.) **Center of Section 35-97-12**
Set 5/8"Ø rebar w/2"Ø aluminum cap PLS 15525

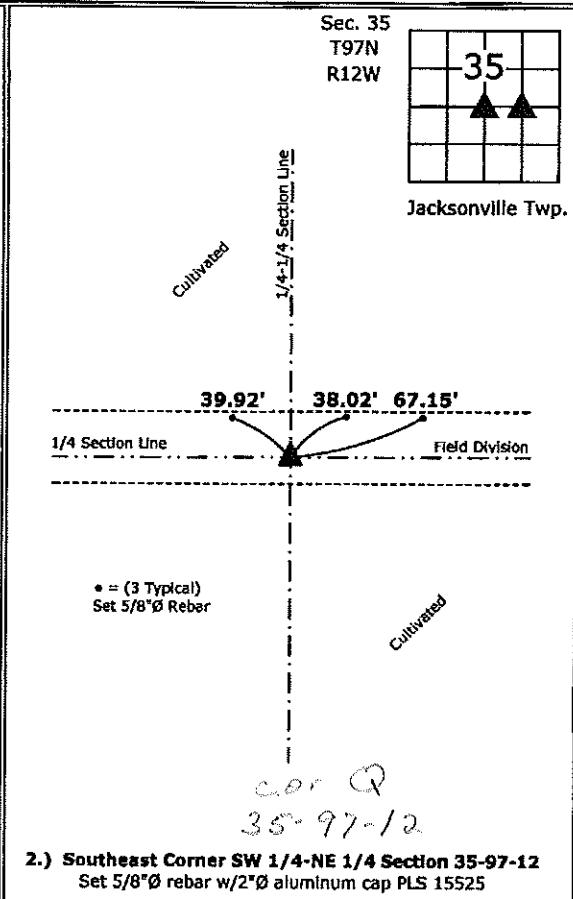

2.) **Southeast Corner SW 1/4-NE 1/4 Section 35-97-12**
Set 5/8"Ø rebar w/2"Ø aluminum cap PLS 15525



I hereby certify that this land surveying document was prepared and the related survey work was performed by me or under my direct personal supervision and that I am a duly licensed Land Surveyor under the laws of the State of Iowa.

Paul R. Herold 6-26-12
Paul R. Herold Date:
License number 15525

List Corners to be Indexed			
Corners	Section	Twp.	Range
CTR	35	97	12
SE-SW-NE	35	97	12