

Sec. 25-97-12
 as referred to in
 Engr. tie book

Harold - Reicks Surveying, 25 1/2 East Main Street, Suite 204, New Hampton, IA 50659, Ph. 641-394-2725

UNITED STATES PUBLIC LAND SURVEY CORNER CERTIFICATE

Land Survey Monuments situated in Section **36**, Township **97 North**, Range **12 West** of the Fifth Principal Meridian, **Chickasaw** County, Iowa. Not previously recorded in the County Recorder's office.

This certificate is being prepared in compliance with Iowa Code Chapter 355.11 because:


- There is no certificate on file for this corner.
- There are no longer three valid ties of record.
- There are changes to reference ties of record.
- There is change of monumentation of record.
- To clarify description of record monument (ties).

Monument Description and Remarks:

- 1.) **North 1/4 Corner:** Found PK nail from information obtained from the Chickasaw County Engineer's office, in field book "Jacksonville Twp. Section Ties", Section 25, Corner "A".
- 2.) **NE Corner:** Found PK nail from information obtained from the Chickasaw County Engineer's office in field book "Jacksonville Twp. Section Ties", Section 25, Corner "B".

PLAN - VIEW

(Show a minimum of three reference ties to durable physical objects, relevant monuments and physical conditions that will enable recovery of the corner.)

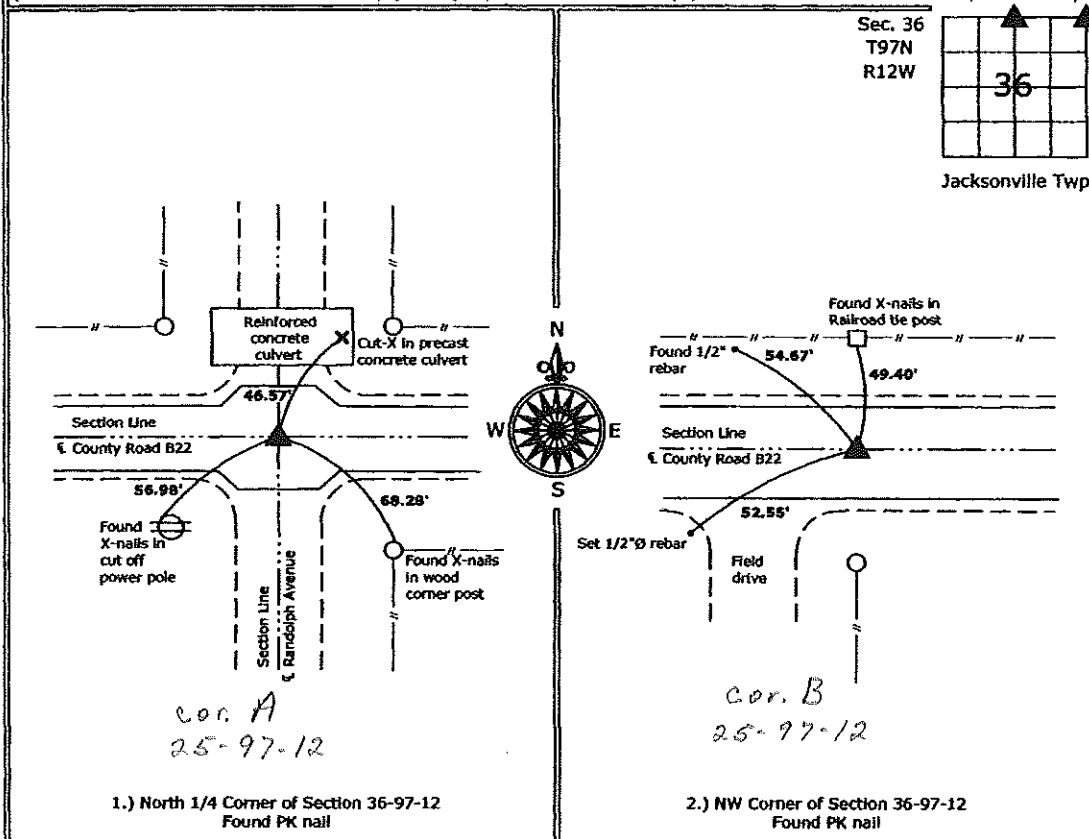

1.) North 1/4 Corner of Section 36-97-12
 Found PK nail

2.) NW Corner of Section 36-97-12
 Found PK nail



I hereby certify that this land surveying document was prepared and the related survey work was performed by me or under my direct personal supervision and that I am a duly licensed Land Surveyor under the laws of the State of Iowa.
Kirk D. Reicks 3-18-09
 Kirk D. Reicks Date:
 License number 19211
 My license renewal date is December 31, 2010.
 Sheets covered by this seal: Individual sheet only

List Corners to be Indexed			
Corners	Section	Twp.	Range
N 1/4	36	97	12
NE	36	97	12

Project Number: 2009-020
 FB: Chickasaw County 3, Pgs. 24-25

File: S:\Projects\2009-020\dwg\2009-020.dwg, 3/18/2009 9:04:53 AM