

UNITED STATES PUBLIC LAND SURVEY CORNER CERTIFICATE

OF

Land Survey Monuments situated in Section 11, Township 95 NORTH, Range 12 WEST, of the Fifth Principal Meridian, CHICKASAW County, Iowa. Previously recorded in NONE in County Recorder's Office.


(book, page, document number, etc.)

(Show reason for preparing this certificate, the evidence and detailed procedures used in establishing the corner positions and monumentation found or placed.)

Monument Description and Remarks: CENTER OF SECTION 11-T95N-R12W:
Set 1/2" φ Rebar w/cap at intersection of County Road E and
N-5 1/4 Section Line Fence as indicated on 1972 & 1980 Surveys.
E 1/4 CORNER, SECTION 11-T95N-R12W: Found 1/2" Twisted Iron Pin.

PLAN - VIEW

(Show a minimum of three reference ties to durable physical objects, relevant monuments and physical conditions that will enable recovery of the corner.)

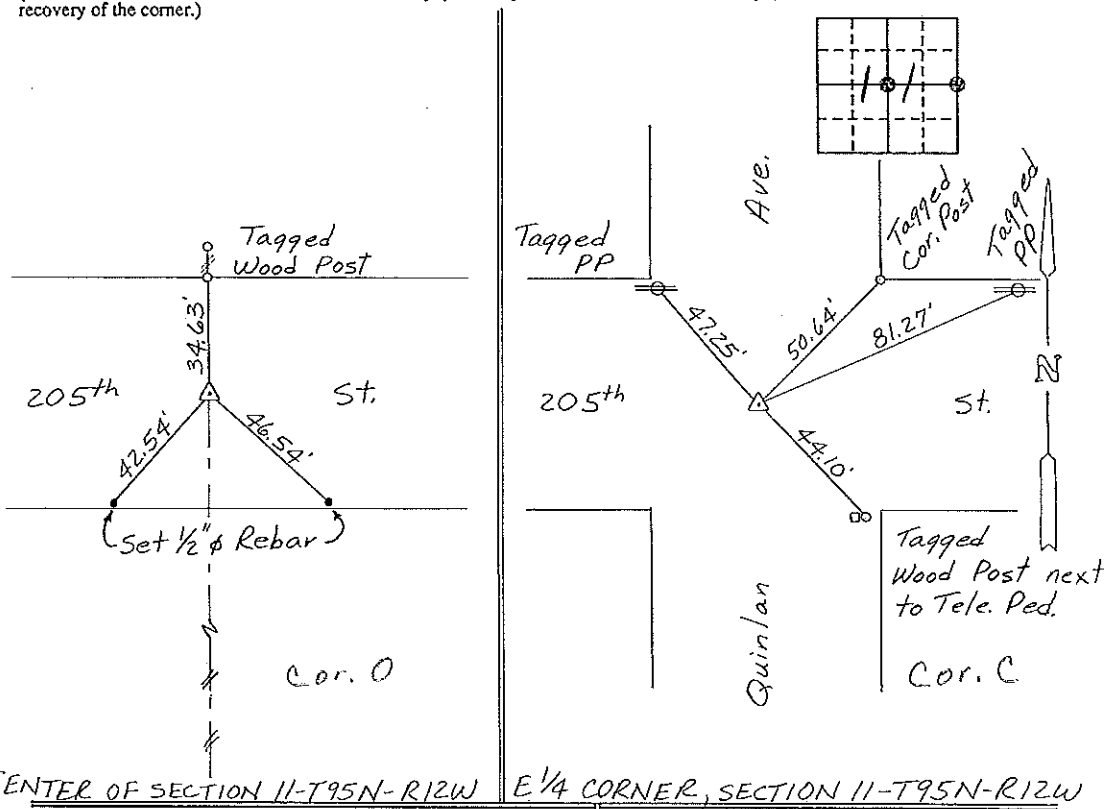


CENTER OF SECTION 11-T95N-R12W E 1/4 CORNER, SECTION 11-T95N-R12W

I hereby certify that the survey work was completed and this certificate was prepared by me or under my direct personal supervision and that I am a duly registered land surveyor under the laws of the state of Iowa.

Signature: Gary L. Casady
 Name typed or printed: Gary L. Casady
 Date: 9-15-93 Reg. No. 12532
 My Registration Expires December 31, 1994

Corners	List Corners to be Indexed	Section	Twp	Range
Center	11	95N	12W	
E 1/4	Cor. O	11-95-12		
	Cor. C	11-95-12		

SEAL

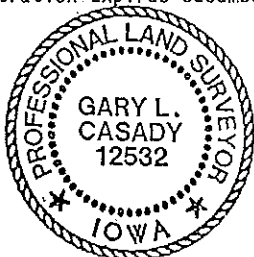

*Placed
Tie Pin 9/30/93*