

Instrument #: 2022-0086  
 01/14/2022 09:50:02 AM Total Pages: 1  
 SCC SECTION CORNER CERTIFICATES  
 Recording Fee: \$ 7.00  
 Shirley Troyna, Recorder, Chickasaw County Iowa



Prepared by & Return to: Herald - Reicks Surveying, 10 East Main Street, New Hampton, IA 50659, Ph. 641-394-2725

### United States Public Land Survey Corner Certificate

Land Survey Monument situated in  
 Section 2, Township 95 North, Range 12 West of the Fifth Principal Meridian, Chickasaw County, Iowa.  
 On file in **Book 153, Page 87** in the County Recorder's office.

This certificate is being prepared in compliance with Iowa Code Chapter 355.11 because:


- There is no certificate on file for this corner.
- There are no longer three valid ties of record.
- There are changes to reference ties of record.
- There is change of monumentation of record.
- To clarify description of record monument (ties).

**Monument Description and Remarks:**

**South 1/4 Corner:** Found 1/2"Ø Rebar w/Orange Plastic Cap PLS 12532 with information obtained from the previously recorded Section Corner Certificate.

#### Plan View

(Show a minimum of three reference ties to durable physical objects, relevant monuments and physical conditions that will enable recovery of the corner.)

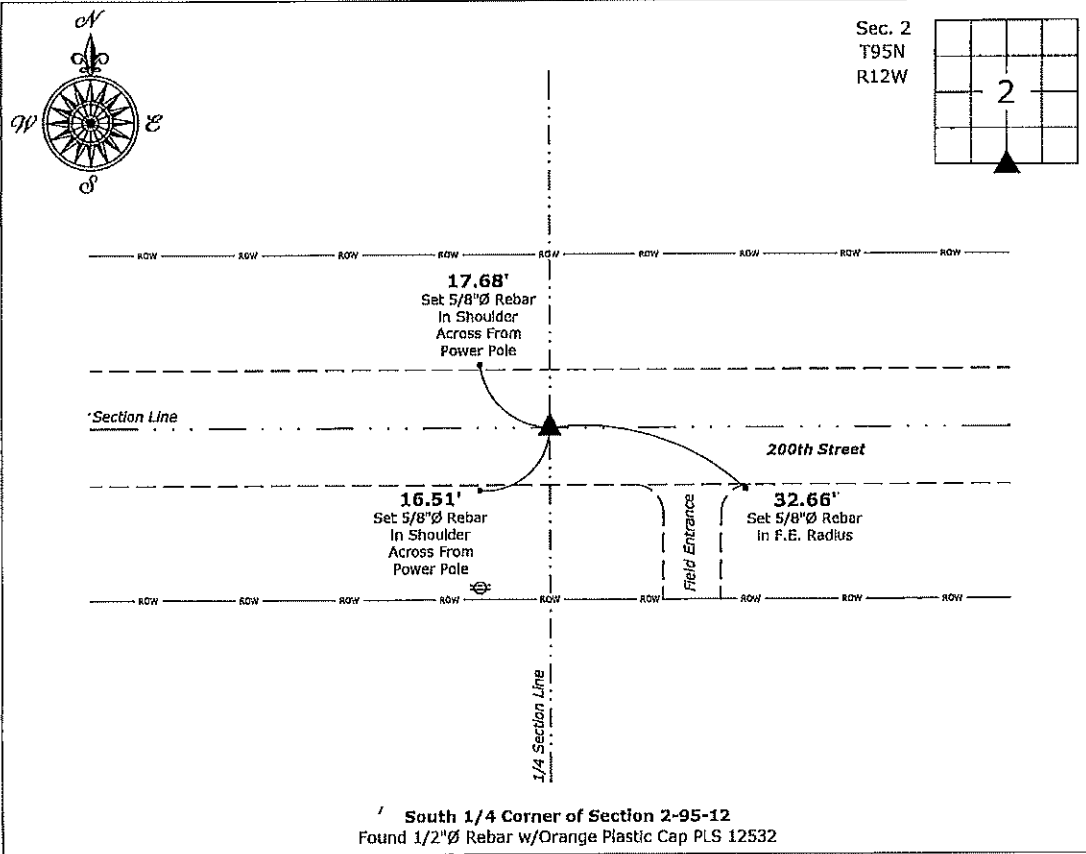

Cor A  
 2-95-12

File: S:\Projects - NHO\County Control Systems - NHO\CHICKASAW\CHICK-29 - 2020.dwg, 1/12/2022 5:29:17 PM

South 1/4 Corner of Section 2-95-12  
 Found 1/2"Ø Rebar w/Orange Plastic Cap PLS 12532



I hereby certify that this land surveying document was prepared and the related survey work was performed by me or under my direct personal supervision and that I am a duly licensed Land Surveyor under the laws of the State of Iowa.

*Kirk D. Reicks* 1-12-2022  
 Kirk D. Reicks Date:

License number 19211  
 My license renewal date is December 31, 2022.  
 Sheets covered by this seal: Individual sheet only

List Corner to be Indexed

Corner	Section	Twp.	Range
S 1/4	2	95	12

Project Number: 2022-006

FB: Chickasaw 11, Pgs. 27-28