


Instrument #: 2022-0084  
 01/14/2022 09:50:02 AM Total Pages: 1  
 SCC SECTION CORNER CERTIFICATES  
 Recording Fee: \$ 7.00  
 Shirley Troyna, Recorder, Chickasaw County Iowa

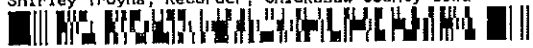

Prepared by & Return to: Herald - Reicks Surveying, 10 East Main Street, New Hampton, IA 50659, Ph. 641-394-2725

### United States Public Land Survey Corner Certificate

Land Survey Monument situated in  
 Section 2, Township 95 North, Range 12 West of the Fifth Principal Meridian, Chickasaw County, Iowa.  
 Not on file in the County Recorder's office.

This certificate is being prepared in compliance with Iowa Code Chapter 355.11 because:

- There is no certificate on file for this corner.
- There are no longer three valid ties of record.
- There are changes to reference ties of record.
- There is change of monumentation of record.
- To clarify description of record monument (ties).


#### Monument Description and Remarks:

**Southwest Corner of the SE 1/4-SE 1/4:** Set 5/8"Ø Rebar w/Aluminum Cap equidistant and on line between the South 1/4 and Southeast Corners of said Section.

An extensive search of all of the records within the County offices was performed as part of the section corner recovery. There were no records located of the perpetuation of a monument at this corner.

#### Plan View

(Show a minimum of three reference ties to durable physical objects, relevant monuments and physical conditions that will enable recovery of the corner.)

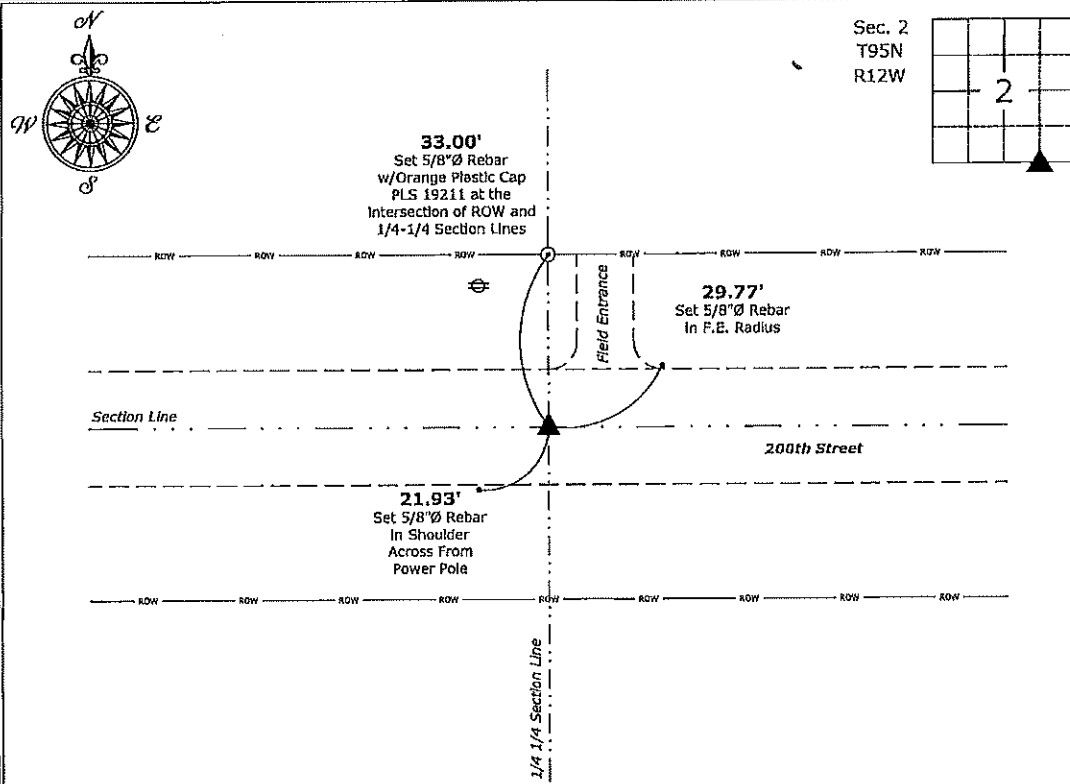

Cor A1  
 2-95-12

**Southwest Corner of the SE 1/4-SE 1/4 of Section 2-95-12**  
 Set 5/8"Ø Rebar w/2"Ø Aluminum Cap PLS 19211



I hereby certify that this land surveying document was prepared by me or under my direct personal supervision and that I am a duly licensed Land Surveyor under the laws of the State of Iowa.  
*Kirk D. Reicks* 1-12-2022  
 Kirk D. Reicks Date:  
 License number 19211  
 My license renewal date is December 31, 2022.  
 Sheets covered by this seal: Individual sheet only

List Corner to be Indexed			
Corner	Section	Twp.	Range
SW-SE-SE	2	95	12

Project Number: 2022-006  
 FB: Chickasaw 11, Pgs. 27-28

File: S:\Projects - NHO\County Control Systems - NHO\CHICKASAW\CHICK-29 - 2020.dwg, 1/12/2022 5:29:25 PM