

Instrument #: 2019-2049  
 12/23/2019 04:21:58 PM Total Pages: 1  
 SCG SECTION CORNER CERTIFICATES  
 Recording Fee: \$ 7.00  
 Shirley Troyne, Recorder, Chickasaw County Iowa



Prepared by & Return to: Herald - Reicks Surveying, 10 East Main Street, New Hampton, IA 50659, Ph. 641-394-2725

## United States Public Land Survey Corner Certificate

Land Survey Monument situated in  
**Section 12, Township 95 North, Range 12 West of the Fifth Principal Meridian, Chickasaw County, Iowa.**  
 Not on file in the County Recorder's office.

This certificate is being prepared in compliance  
 with Iowa Code Chapter 355.11 because:

}  There is no certificate on file for this corner.  
 There are no longer three valid ties of record.  
 There are changes to reference ties of record.  
 There is change of monumentation of record.  
 To clarify description of record monument (ties).


### Monument Description and Remarks:

**Southeast Corner SW 1/4-SW 1/4:** Set 5/8"Ø Rebar with Aluminum Cap PLS 19211 equidistant and online between the Southwest and South 1/4 Corners of said Section.

An extensive search of all of the records within the County offices was performed as part of the section corner recovery. No records were located of the perpetuation of a monument at this corner.

### Plan View


(Show a minimum of three reference ties to durable physical objects, relevant monuments and physical conditions that will enable recovery of the corner.)

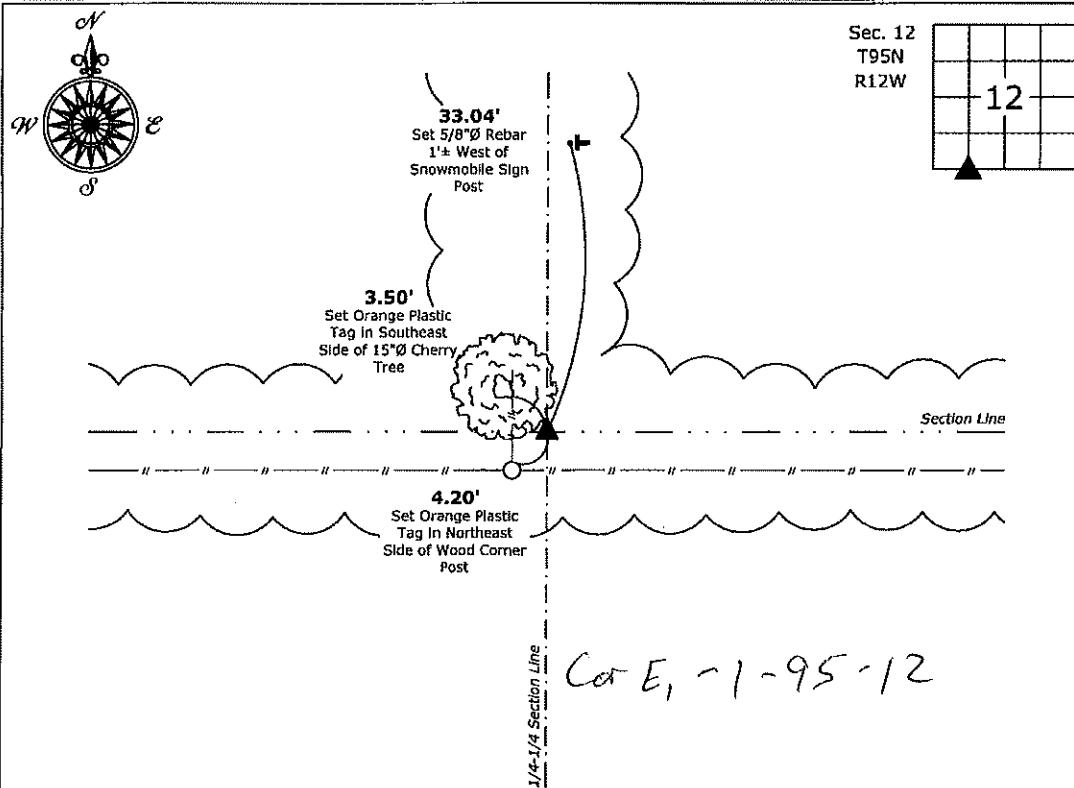

File: S:\\_Projects - NHO\County Control Systems - NHO\CHICKASAW\CHICK-29.dwg, 12/23/2019 8:10:29 AM

### Southeast Corner SW 1/4-SW 1/4 of Section 12-95-12

Set 5/8"Ø Rebar with Aluminum Cap PLS 19211

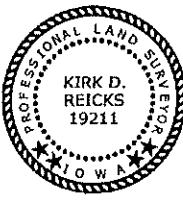

I hereby certify that this land surveying document was prepared and the related survey work was performed by me or under my direct personal supervision and that I am a duly licensed Land Surveyor under the laws of the State of Iowa.

Kirk D. Reicks 12-23-19  
 Kirk D. Reicks Date:

License number 19211

My license renewal date is December 31, 2020.  
 Sheets covered by this seal: Individual sheet only

### List Corner to be Indexed

Corner	Section	Twp.	Range
SE-SW-SW	12	95	12

Project Number: 2019-122

FB: Chickasaw 10, Pgs. 8-9