

Chickasaw Co. Recorder  
 Cindy Messersmith  
**Fee Book 2009-1117**  
 06/02/2009 00146PM  
 SCC SEC COR CERT  
 Book: Page: # Pages: 1  
 Total Fees: \$7.00

*Herold - Racks Surveying, 25 1/2 East Main Street, Suite 204, New Hampton, IA 50659, Ph. 641-394-2725*

### UNITED STATES PUBLIC LAND SURVEY CORNER CERTIFICATE

Land Survey Monuments situated in Section **16**, Township **95** North, Range **12** West of the Fifth Principal Meridian, **Chickasaw** County, Iowa, not previously recorded in the County Recorder's office.

This certificate is being prepared in compliance with Iowa Code Chapter 355.11 because:


- There is no certificate on file for this corner.
- There are no longer three valid ties of record.
- There are changes to reference ties of record.
- There is change of monumentation of record.
- To clarify description of record monument (ties).

#### Monument Description and Remarks:


NE Corner SE 1/4-SE 1/4 Section 16-95-12: Set 5/8"Ø rebar w/2"Ø aluminum cap PLS 15525 at the record location as shown on a survey and plat recorded as Doc. #2004-0292

#### PLAN - VIEW

(Show a minimum of three reference ties to durable physical objects, relevant monuments and physical conditions that will enable recovery of the corner.)

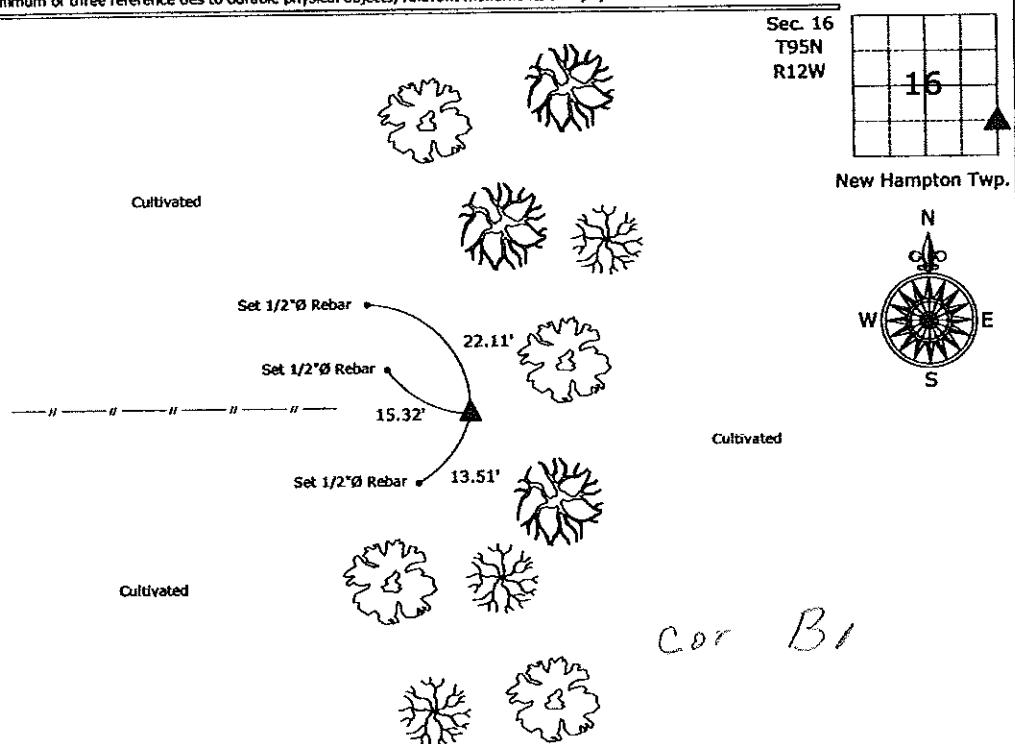

NE Corner SE 1/4-SE 1/4 Section 16-95-12  
Set 5/8"Ø rebar w/2"Ø aluminum cap PLS 15525

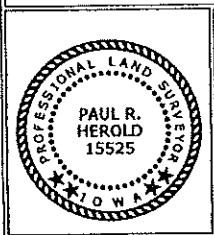

I hereby certify that this land surveying document was prepared and the related survey work was performed by me or under my direct personal supervision and that I am a duly licensed Land Surveyor under the laws of the State of Iowa.

Paul R. Herold 6-2-09

Paul R. Herold

Date:  
License number 15525  
My license renewal date is December 31, 2010.  
Sheets covered by this seal: Individual sheet only

List Corners to be Indexed			
Corners	Section	Twp.	Range
NE-SE-SE	16	95	12

Project Number: 2009-058  
FB: Chickasaw County 3, Pg. 33