

Section 9-95-12  
As referred to in  
Engr. Tie Book

SLSI 9-90

UNITED STATES PUBLIC LAND SURVEY CORNER CERTIFICATE

OF 9



Land Survey Monuments situated in Section 16, Township 95 NORTH, Range 12 WEST, of the Fifth Principal Meridian, CHICKASAW County, Iowa.  
Previously recorded in NONE in County Recorder's Office.

(Show reason for preparing this certificate, the evidence and detailed procedures used in establishing the corner positions and monumentation found or placed.)

Monument Description and Remarks: N 1/4 CORNER, SECTION 16-T95N-R12W  
Set 1/2" φ Rebar w/cap from record Survey made Sept. 29, 1910, recorded in Survey Plats & Field Notes Bk. #1, pg 204 on file in the Chickasaw Co. Eng. offi.  
CENTER OF SECTION 16-T95N-R12W: Set 1/2" φ Rebar w/cap from record Survey made Sept. 29, 1910, recorded in Survey Plats & Field Notes Bk. #1, pg 204 on file in the Chickasaw County Engineer's office.

PLAN - VIEW

(Show a minimum of three reference ties to durable physical objects, relevant monuments and physical conditions that will enable recovery of the corner.)

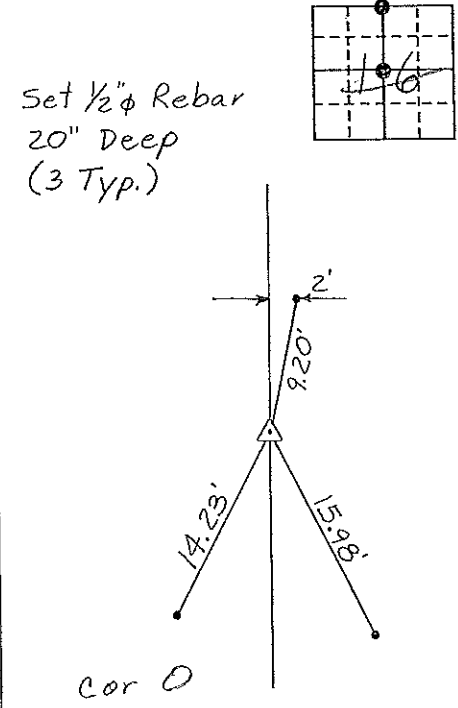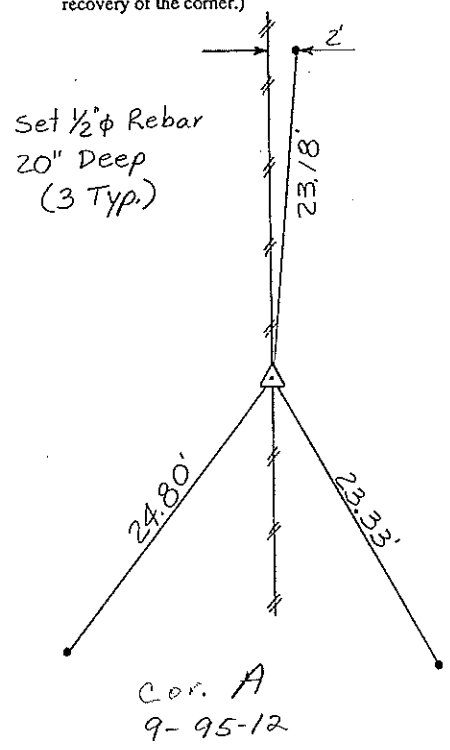

N 1/4 CORNER, SECTION 16-T95N-R12W      CENTER OF SECTION 16-T95N-R12W

I hereby certify that the survey work was completed and this certificate was prepared by me or under my direct personal supervision and that I am a duly registered land surveyor under the laws of the state of Iowa.

Signature: Gary L. Casady  
Name typed or printed: Gary L. Casady  
Date: 5-2-94 Reg. No. 12532  
My Registration Expires December 31, 1994

Corners	List Corners to be Indexed		
	Section	Twp	Range
N 1/4 corner A	16	95N	12W
CENTER	16	95N	12W
CORNER O	16	95	12



SEAL

Placed in Tie  
book 5/25/94