

Prepared by Harold - Reicks Surveying, 13 East Main Street, New Hampton, IA 50659, Ph. 641-394-2725 Fax. 641-394-2718

UNITED STATES PUBLIC LAND SURVEY CORNER CERTIFICATE

Land Survey Monuments situated in Section 9, Township 95 North, Range 12 West of the Fifth Principal Meridian, Chickasaw County, Iowa. 1.) Previously recorded in Bk. 2001, Pg. 2814 in the County Recorder's office. 2.) Not previously recorded in the County Recorders Office.

This certificate is being prepared in compliance with Iowa Code Chapter 355.11 because:

- 2.) There is no certificate on file for this corner.
- There are no longer three valid ties of record.
- 1.) There are changes to reference ties of record.
- There is change of monumentation of record.
- To clarify description of record monument (ties).


Monument Description and Remarks:

1.) **Center of Section:** Found T-bar 4" deep from information obtained from the previous Section Corner Certificate.

2.) **SE Corner SW 1/4-SE 1/4:** Set 5/8"Ø rebar with 2"Ø aluminum cap PLS 19211 online between and at the record distance from the SE and S 1/4 Corners per Plat of Survey made by Paul R. Herold, recorded as Document #2001-2816 on file in the Chickasaw County Recorder's office.

PLAN - VIEW

(Show a minimum of three reference ties to durable physical objects, relevant monuments and physical conditions that will enable recovery of the corner.)

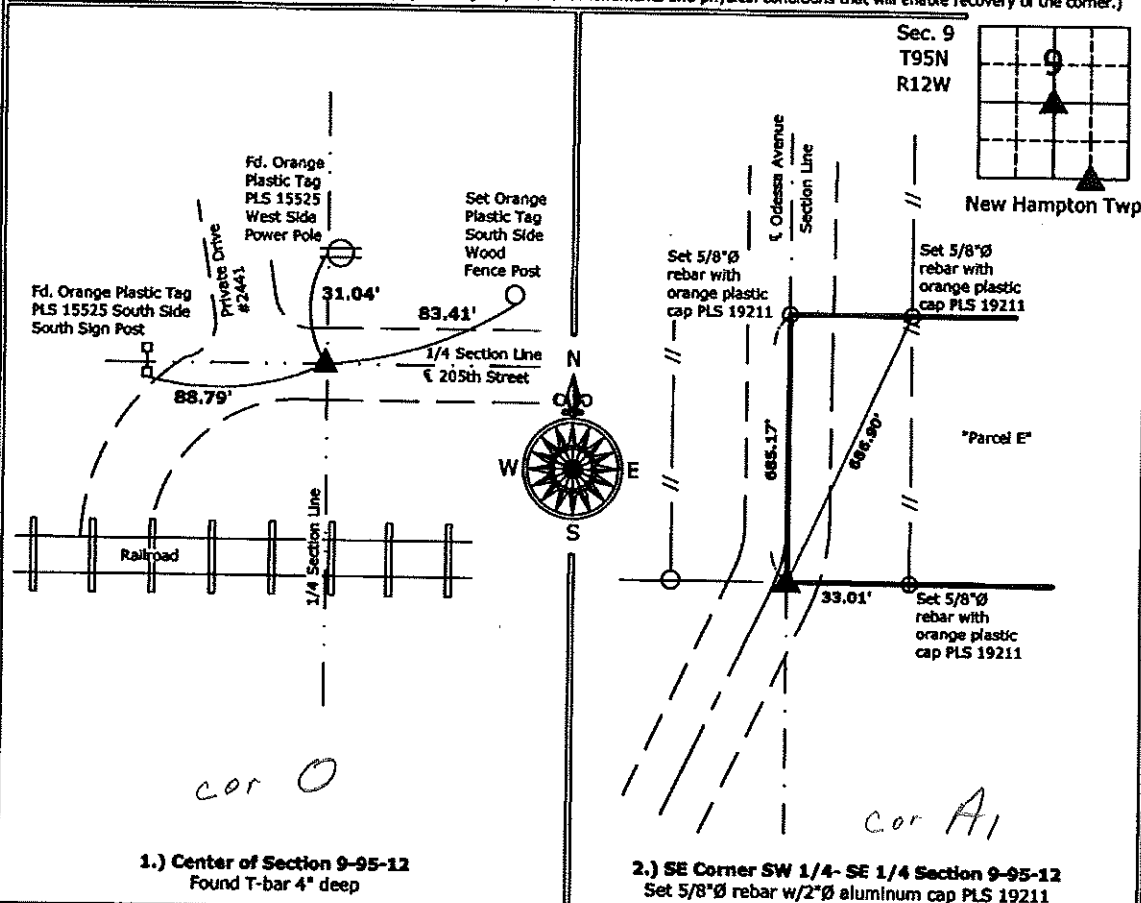

1.) Center of Section 9-95-12
 Found T-bar 4" deep

2.) SE Corner SW 1/4- SE 1/4 Section 9-95-12
 Set 5/8"Ø rebar w/2"Ø aluminum cap PLS 19211



I hereby certify that this land surveying document was prepared and the related survey work was performed by me or under my direct personal supervision and that I am a duly licensed Land Surveyor under the laws of the State of Iowa.

Kirk D. Reicks 3-2-10
 Kirk D. Reicks Date:

License number 19211
 My license renewal date is December 31, 2010.
 Sheets covered by this seal: Individual sheet only

List Corners to be Indexed			
Corners	Section	Twp.	Range
CTR	9	95	12
SE-SW-SE	9	95	12

Project Number: 2009-157

FB: Chickasaw County 2, Pgs. 27-28