

Instrument #: 2023-1985
11/02/2023 02:09:16 PM Total Pages: 1
SCC SECTION CORNER CERTIFICATES
Recording Fee: \$ 7.00
Shirley Troyna, Recorder, Chickasaw County Iowa



Prepared by & Return to: Kirk D. Reicks, HRS, LLC, 10 East Main Street, New Hampton, IA 50659, Phone 641-394-2725

United States Public Land Survey Corner Certificate

Land Survey Monument situated in
Section 16, Township 95 North, Range 12 West of the Fifth Principal Meridian, **Chickasaw** County, Iowa.
Not on file in the County Recorder's Office.

This certificate is being prepared in compliance with Iowa Code Chapter 355.11 because: {


- There is no certificate on file for this corner.
- There are no longer three valid ties of record.
- There are changes to reference ties of record.
- There is change of monumentation of record.
- To clarify description of record monument (ties).

Monument Description and Remarks:

Southwest Corner of the NW 1/4 - SW 1/4: Set 5/8"Ø Rebar with 2"Ø Aluminum Cap PLS 19211 equidistant and on line between the West 1/4 and Southwest Corners of said Section.

Plan View - Not to Scale

(Show a minimum of three reference ties to durable physical objects, relevant monuments and physical conditions that will enable recovery of the corner.)

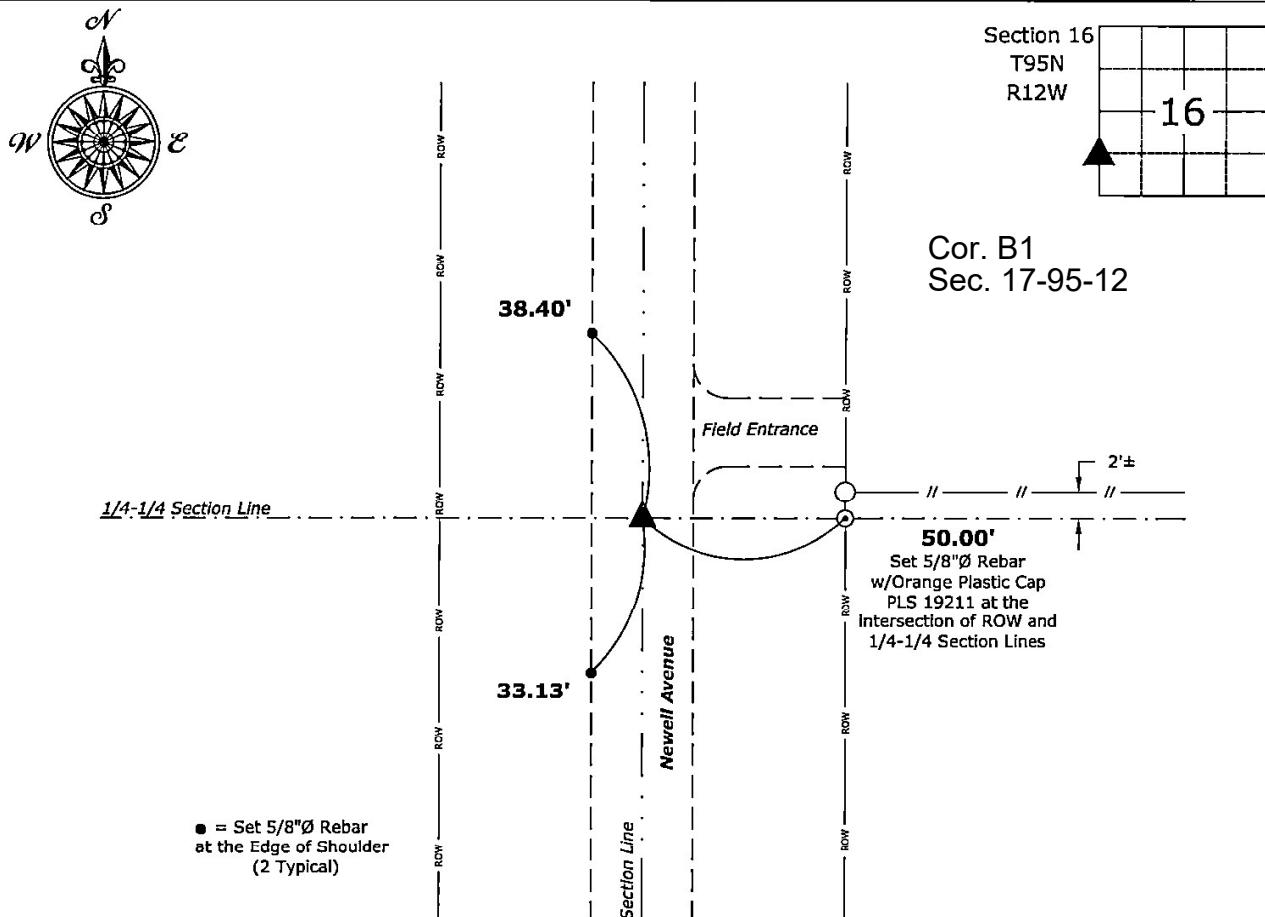

Southwest Corner of the NW 1/4 - SW 1/4 of Section 16-95-12
Set 5/8"Ø Rebar w/2"Ø Aluminum Cap PLS 19211

	I hereby certify that this land surveying document was prepared and the related survey work was performed by me or under my direct personal supervision and that I am a duly licensed Land Surveyor under the laws of the State of Iowa. <i>Kirk D. Reicks</i> <i>11-1-2023</i> Kirk D. Reicks Date: License number 19211 My license renewal date is December 31, 2024. Sheets covered by this seal: Individual sheet only	<p>List Corner to be Indexed</p> <table><thead><tr><th>Corner</th><th>Section</th><th>Township</th><th>Range</th></tr></thead><tbody><tr><td>SW-NW-SW</td><td>16</td><td>95</td><td>12</td></tr></tbody></table> <p>Project Number: 2023-120</p> <p>FB: Chickasaw 12, Page(s) 33-34</p>	Corner	Section	Township	Range	SW-NW-SW	16	95	12
Corner	Section	Township	Range							
SW-NW-SW	16	95	12							