

FILED 2001 -1719  
 RECORDER'S OFFICE  
 CHICKASAW COUNTY, IOWA

2001 AUG 14 AM 9:55

CINDY MESSERSMITH  
 COUNTY RECORDER

TEKIPPE ENGINEERING, P.C., 128 South Vine Street, West Union, Iowa 52176 Phone (563) 422-5131

UNITED STATES PUBLIC LAND SURVEY CORNER CERTIFICATE

OF

Land Survey Monuments situated in Section 8, Township 95 North, Range 12 West of the Fifth Principal Meridian, CHICKASAW County, Iowa. Previously recorded in none in County Recorder's Office. (book, page, document number, etc.)

(Show reason for preparing this certificate, the evidence and detailed procedures used in establishing the corner positions and monumentation found or placed.)


Monument Description and Remarks: SE Corner NW 1/4 - SW 1/4 Section 8 T95N R12W: Found 1/2"Ø iron pin w/brass cap RLS 2886 with information obtained from a Survey and Plat made by L.P. Erdman, recorded on June 8, 1982 in Book 126, Pages 342-343.

SE Corner Section 8 T95N R12W: Found 5/8"Ø rebar w/yellow plastic cap 7549 with information obtained from the Chickasaw County Engineer's Office in the Field Book for New Hampton Twp. Corner Ties, Section 8, Corner B.

PLAN - VIEW


Project Number 01114.15  
 FR. New Hampton I PG. 10-21

(Show a minimum of three reference ties to durable physical objects, relevant monuments and physical conditions that will enable recovery of the corner.)

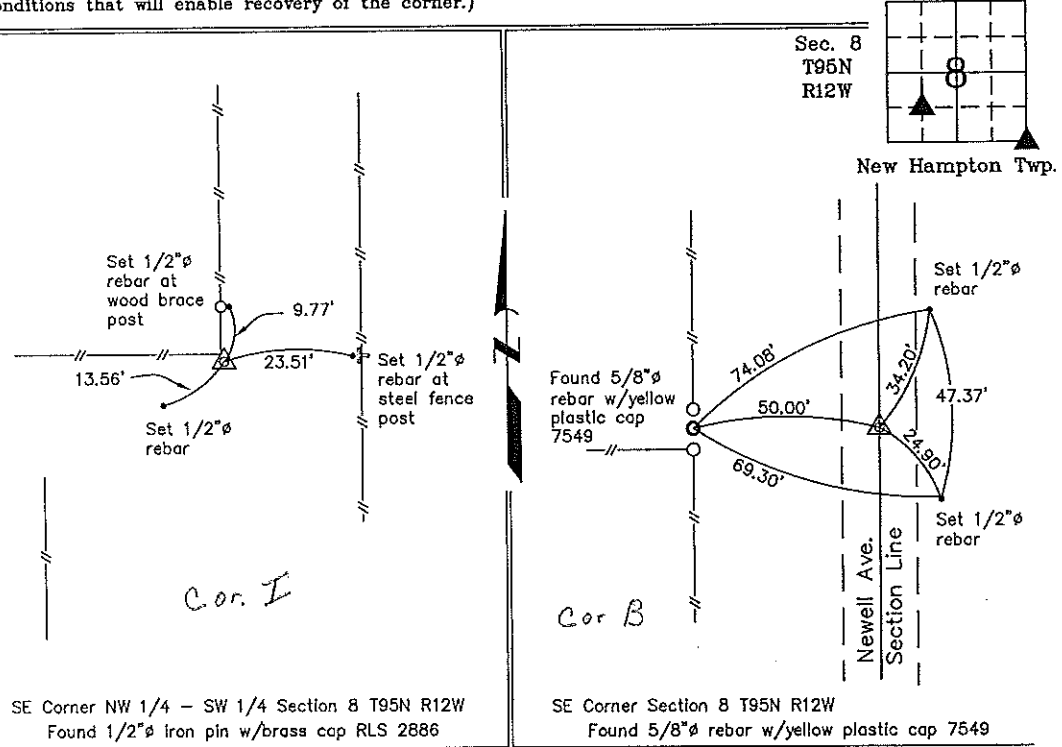

SE Corner NW 1/4 - SW 1/4 Section 8 T95N R12W  
 Found 1/2"Ø iron pin w/brass cap RLS 2886

SE Corner Section 8 T95N R12W  
 Found 5/8"Ø rebar w/yellow plastic cap 7549

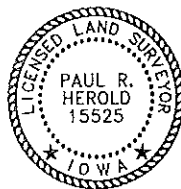

I hereby certify that this land surveying document was prepared and the related survey work was performed by me or under my direct personal supervision and that I am a duly licensed Land Surveyor under the laws of the State of Iowa.  
*Paul R. Herold* 8-13-01  
 Paul R. Herold Date  
 License number 15525  
 My license renewal date is December 31, 2002.  
 Sheets covered by this seal: Individual

List Corners to be Indexed			
Corners	Section	Twp.	Range
SE-NW-SW	8	95N	12W
SE	8	95N	12W

Filed 10-11-01

County Engineer's Copy