

FILED 2001-1722
RECORDER'S OFFICE
CHICKASAW COUNTY, IOWA

2001 AUG 14 AM 9:56

CINDY MESSERSMITH
COUNTY RECORDER

TeKIPPE ENGINEERING, P.C., 128 South Vine Street, West Union, Iowa 52175 Phone (563) 422-5131

UNITED STATES PUBLIC LAND SURVEY CORNER CERTIFICATE

OF

Land Survey Monuments situated in Section 17, Township 95 North, Range 12 West of the Fifth Principal Meridian, CHICKASAW County, Iowa.
Previously recorded in none in County Recorder's Office.
(book, page, document number, etc.)


(Show reason for preparing this certificate, the evidence and detailed procedures used in establishing the corner positions and monumentation found or placed.)

Monument Description and Remarks: S 1/4 Corner Section 17 T95N R12W: Set 1/2"Ø rebar w/2"Ø aluminum cap PLS 15525 at the split of the R.O.W on the extension of the 1/4 Section Line fences.


PLAN - VIEW

Project Number 01115.15
FR. New Hampton 1 PG. 18-21

(Show a minimum of three reference ties to durable physical objects, relevant monuments and physical conditions that will enable recovery of the corner.)

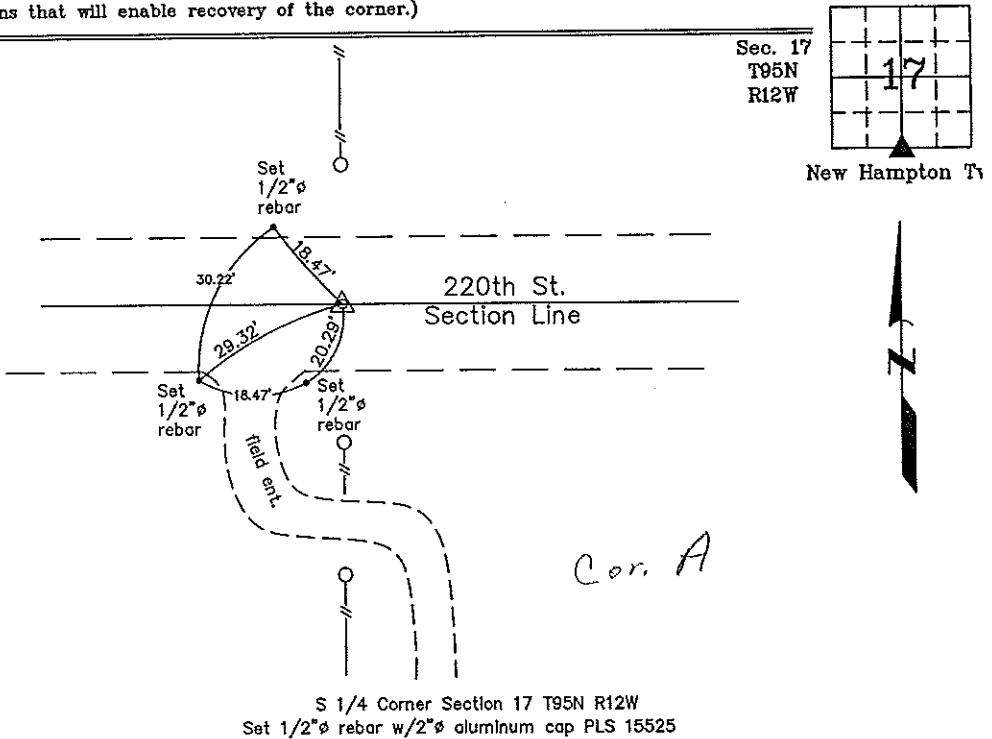

S 1/4 Corner Section 17 T95N R12W
Set 1/2"Ø rebar w/2"Ø aluminum cap PLS 15525

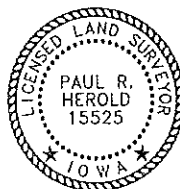

I hereby certify that this land surveying document was prepared and the related survey work was performed by me or under my direct personal supervision and that I am a duly licensed Land Surveyor under the laws of the State of Iowa.

Paul R. Herold 8-13-01
Paul R. Herold Date
License number 15525
My license renewal date is December 31, 2002.
Sheets covered by this seal: Individual

List Corners to be Indexed			
Corners	Section	Twp.	Range
S 1/4	17	95N	12W

Entered 1-11-02

County Engineer
Paul R. Herold