

Section 15-95-12
As referred to in
Eng. The Book

FILED 2004 - 0832
RECORDER'S OFFICE
CHICKASAW COUNTY, IOWA
2004 APR 12 AM 9 35

CINDY MESSERSMITH
COUNTY RECORDER


Prepared by: Erdman Engineering, P.C., 708 Commerce Drive, P.O. Box 246, Decorah, Iowa 52101 (563) 382-4194

United States Public Land Survey Corner Certificate
of

Land Survey Monuments situated in Section 22, Township 95, Range 12 West of
the 5th Principal Meridian in Chickasaw County, Iowa. Previously recorded in
does not apply in the county Recorder's Office.

Monument Description and Remarks: This certificate is prepared in accordance with
Section 193C of the Code of Iowa. No previous certificate has been filed for this
corner location. We found no record of the NNE $\frac{1}{8}$ Corner being set. We found no
evidence of a monument in the field other than the county road. We found the NE
corner and the N $\frac{1}{4}$ Corner. Based on these monuments we set a $\frac{1}{2}$ " diameter steel bar
with 1 $\frac{1}{2}$ " aluminum cap #11442 on line and equidistant between the N $\frac{1}{4}$ Corner and
the NE Corner as the NNE $\frac{1}{8}$ Corner of Section 22, Township 95 North, Range 12 West.


Plan-View

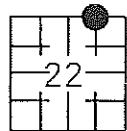


Nail with orange plastic
cap #11442 on south
side of cluster of small
Maples

Nail with orange plastic
cap #11442 on south
side 24" Maple

Nail with orange plastic
cap #11442 on south
side 24" Maple

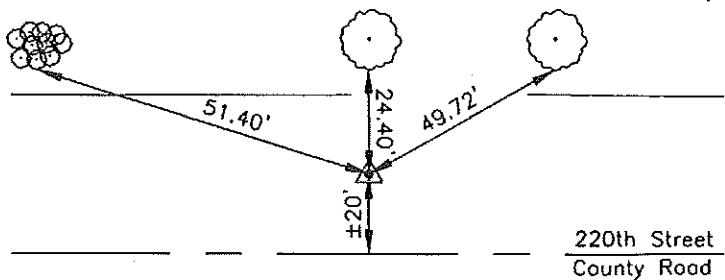

cor A,
15-95-12

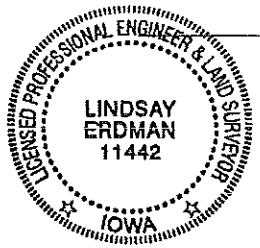

I hereby certify that the survey work was completed
and this certificate was prepared by me or under my
direct supervision and that I am a duly registered
land surveyor under the laws of the State of Iowa.

Signature: Lindsay Erdman
Lindsay Erdman, P.E. and P.L.S. Iowa License Number 11442

Date: 4/8/04

My license renewal date is December 31, 2004

Corner(s) to be Indexed

Corner	Section	Township	Range
NNE 1/8	22	95	12