

Chickasaw Co. Recorder  
 Cindy Messersmith  
**Fee Book 2009-2311**  
 12/17/2009 00401PM  
 SCC SEC COR CERT  
 Book: Page: # Pages: 1  
 Total Fees: \$9.00

Herold - Recks Surveying, 25 1/2 East Main Street, Suite 204, New Hampton, IA 50659, Ph. 641-394-2725

**UNITED STATES PUBLIC LAND SURVEY CORNER CERTIFICATE**

22

Land Survey Monuments situated in Section 26, Township 95 North, Range 12 West of the Fifth Principal Meridian, **Chickasaw** County, Iowa. Previously recorded in Bk. 2000, Pg. 2242 in the County Recorder's office.

This certificate is being prepared in compliance with Iowa Code Chapter 355.11 because:



- There is no certificate on file for this corner.
- There are no longer three valid ties of record.
- There are changes to reference ties of record.
- There is change of monumentation of record.
- To clarify description of record monument (ties).


**Monument Description and Remarks:**

**Northwest Corner:** Set 5/8"Ø rebar with 2"Ø aluminum cap PLS 15525. The previous monument was removed when the culvert was replaced.



Sec. 22 - 95- 22  
 As referred to  
 Engr. Tie Book

**PLAN - VIEW**

(Show a minimum of three reference ties to durable physical objects, relevant monuments and physical conditions that will enable recovery of the corner.)

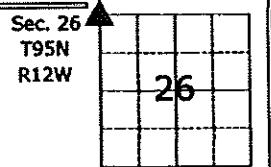

New Hampton Twp.

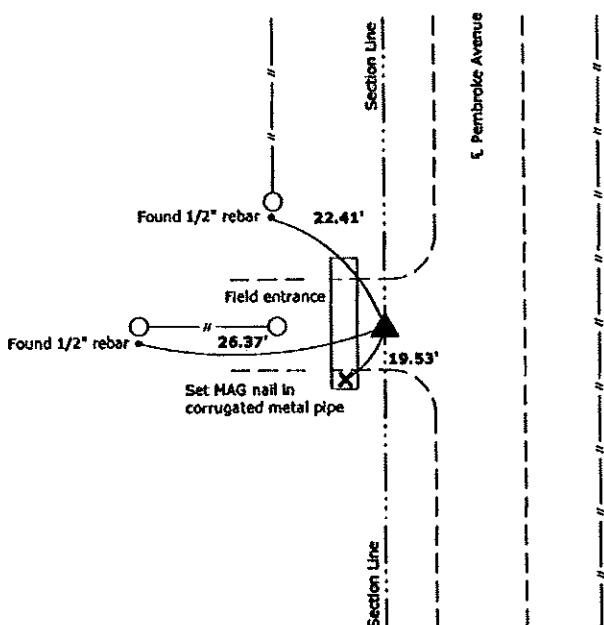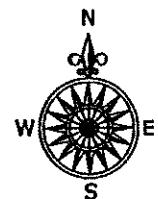

Northwest Corner Section 26-95-12  
 Set 5/8"Ø rebar with 2"Ø aluminum cap PLS 15525

I hereby certify that this land surveying document was prepared and the related survey work was performed by me or under my direct personal supervision and that I am a duly licensed Land Surveyor under the laws of the State of Iowa.

Paul R. Herold 12-16-09

Paul R. Herold

Date:

License number 15525

My license renewal date is December 31, 2010.  
 Sheets covered by this seal: Individual sheet only

**List Corners to be Indexed**

Corners	Section	Twp.	Range
NW	26	95	12

Project Number: 2009-142

FB: Chickasaw County 3, Pgs. 44-45



Section 22-95-12  
As referred to in  
Engt. the Book

TeKIPPE ENGINEERING, P.C., 128 South Vine Street, West Union, Iowa 52176 Phone (319) 422-5131

UNITED STATES PUBLIC LAND SURVEY CORNER CERTIFICATE

OF 22

Land Survey Monuments situated in Section 23, Township 95 North, Range 12 West of the Fifth Principal Meridian, CHICKASAW County, Iowa  
Previously recorded in none in County Recorder's Office  
(book, page, document number, etc.)


(Show reason for preparing this certificate, the evidence and detailed procedures used in establishing the corner positions and monumentation found or placed.)

Monument Description and Remarks: SW Corner Section 23 T95N R12W: Set 1/2"Ø rebar with 2"Ø aluminum cap LS 7060. Set at record location 20 feet west of the center of the road. Data obtained from the Chickasaw County Engineer's office in Field Book New Hampton Township Corner Ties - Corner B, Section 22.


Project Number 00194-LS  
FB. 48H PG. 37-41

PLAN - VIEW

(Show a minimum of three reference ties to durable physical objects, relevant monuments and physical conditions that will enable recovery of the corner.)

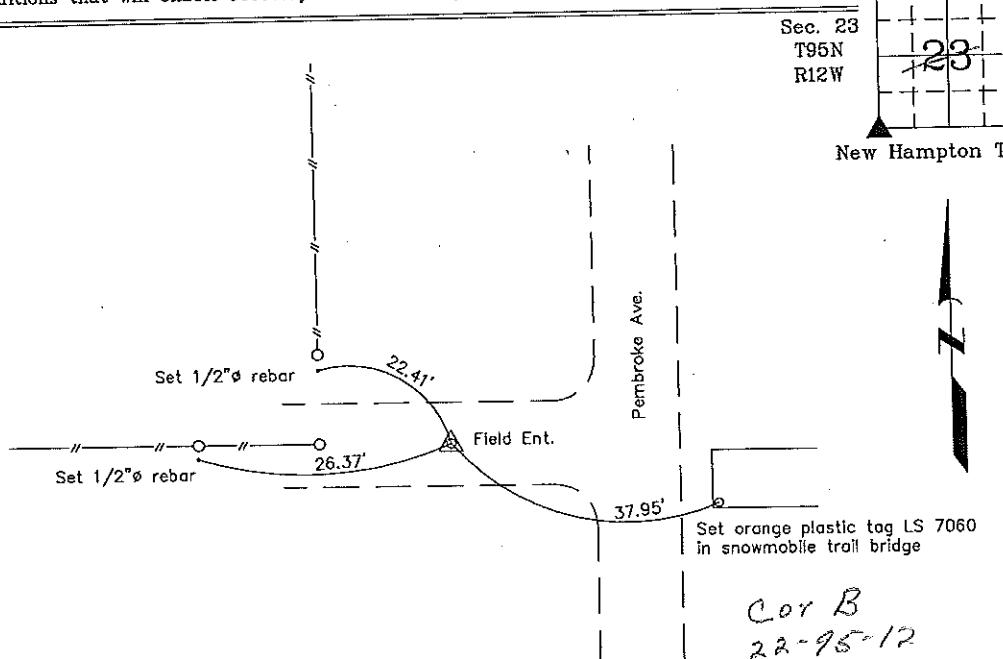

SW Corner Section 23 T95N R12W  
Set 1/2"Ø rebar w/2"Ø aluminum cap LS 7060

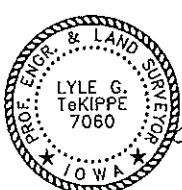

I hereby certify that this land surveying document was prepared and the related survey work was performed by me or under my direct personal supervision and that I am a duly licensed Land Surveyor under the laws of the State of Iowa.

LYLE G. TEKIPPE 12-15-00  
Date  
License number 7060  
My license renewal date is December 31, 2000.  
Sheets covered by this seal: Individual

Corners	List Corners to be Indexed		
	Section	Twp.	Range
SW	23	95	12
B	22	95	12

Filed 3-19-01

2000-2242

County  
Copy