

FILED 2002-0068

REORDER'S OFFICE
CHICKASAW COUNTY, IOWA

file #600
2002 JAN 9 AM 9 09

CINDY MESSERSMITH
COUNTY RECORDER

TEKIPPE ENGINEERING, P.C., 128 South Vine Street, West Union, Iowa 62176 Phone (663) 422-6191

UNITED STATES PUBLIC LAND SURVEY CORNER CERTIFICATE

OF

Land Survey Monuments situated in Section 27, Township 95 North, Range 12 West of the Fifth Principal Meridian, CHICKASAW County, Iowa. Previously recorded in (1) Book 154 Page 128 (2) none in County Recorder's Office. (book, page, document number, etc.)


(Show reason for preparing this certificate, the evidence and detailed procedures used in establishing the corner positions and monumentation found or placed.)

Monument Description and Remarks: (1) W 1/4 Corner Section 27 T95N R12W: Found 1" pipe with information obtained from the previous Section Corner Certificate recorded in the Chickasaw County Recorder's Office in Book 154, Page 128. Placed 1/2" rebar w/2" aluminum cap PLS 15525 inside pipe. Two of the previous reference ties were missing. Two reference ties were added. (2) E 1/4 Corner Section 27 T95N R12W: Found 1-1/2" x 1/4" bent flat iron with information obtained from the Chickasaw County Engineer's Office in Field Book New Hampton Twp. Corner Ties, Section 27, Corner 'C'. Set 1/2" rebar w/2" aluminum cap PLS 15525.

PLAN - VIEW

Project Number 01236.LS
FB. 48H PG. 64-88

(Show a minimum of three reference ties to durable physical objects, relevant monuments and physical conditions that will enable recovery of the corner.)

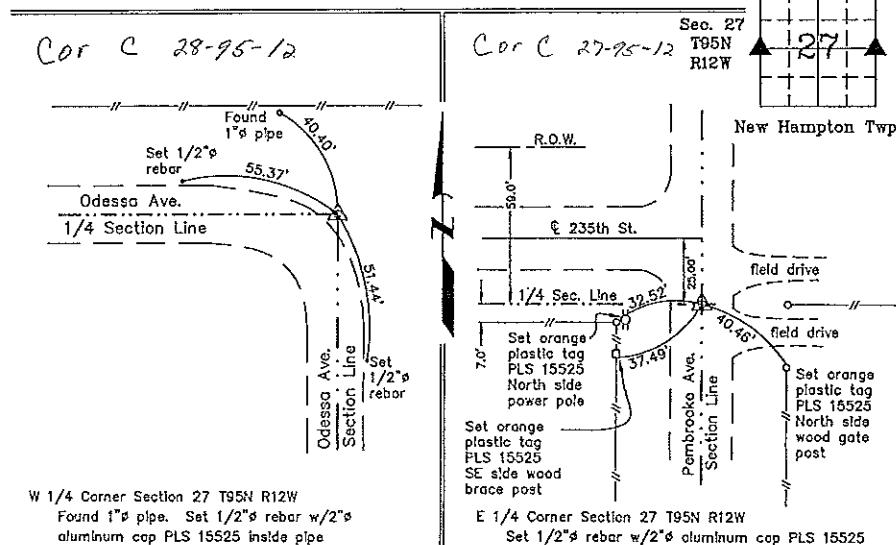

I hereby certify that this land surveying document was prepared and the related survey work was performed by me or under my direct personal supervision and that I am a duly licensed Land Surveyor under the law of the State of Iowa.
Paul R. Herold
Date
License number 15525
My license renewal date is December 31, 2002.
Sheets covered by this seal: Individual

List Corners to be indexed

Corners	Section	Twp.	Range
W 1/4	27	95N	12W
E 1/4	27	95N	12W

Section 28-95-12
As referred to in
Engr. Tie Book

SL319-90

UNITED STATES PUBLIC LAND SURVEY CORNER CERTIFICATE


OF

nd Survey Monuments situated in Section 27 28, Township 95N, Range 12 W, of the Fifth Principal Meridian, Chickasaw County, Iowa. Previously recorded in does not apply in County Recorder's Office.

(book, page, document number, etc.)
(low reason for preparing this certificate, the evidence and detailed procedures used in establishing the corner positions and monumentation found or placed.)
Monument Description and Remarks: see below

PLAN - VIEW

Show a minimum of three reference ties to durable physical objects, relevant monuments and physical conditions that will enable recovery of the corner.

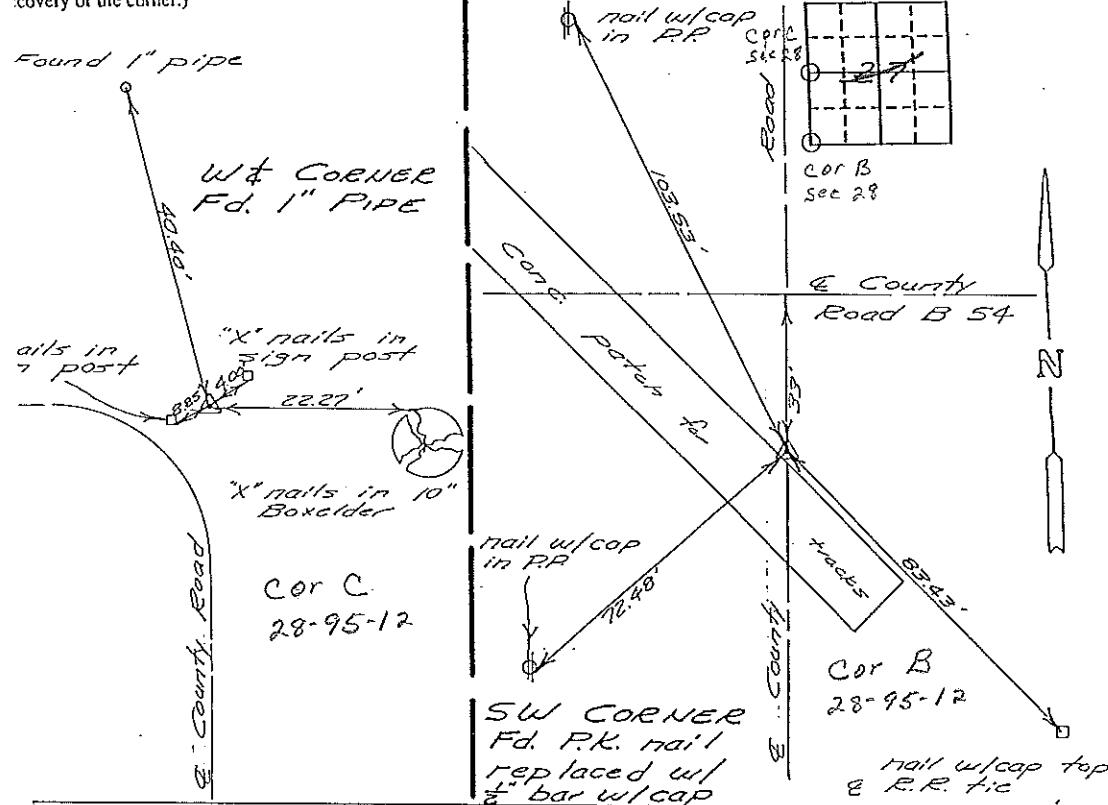

I hereby certify that the survey work was completed and this certificate was prepared by me or under my direct personal supervision and that I am a duly registered land surveyor under the laws of the state of Iowa.

Signature: L. P. Erdman

Name typed or printed: C. P. Erdman

Date: 1-18-94 Reg. No. 2886

List Corners to be Indexed
Corners Section Twp Range

W 1/4 27 95N 12 W

S 1/4 27 95N 12 W

SEAL



DOCUMENT NO. 01596

RECORDING FEE 6.00

TRANSFER FEE 5.00

FILED FOR RECORD THE 22nd DAY OF February 1994 AT 7:43 A.M. REC'D. BY LETTIE H. ROSS

STATE OF IOWA, CHICKASAW COUNTY,

9-17-2
T. Jacobs

Recorder