

Section 20-95-12  
 As referred to in  
 Engr. Tie Book

SLS19-90

UNITED STATES PUBLIC LAND SURVEY CORNER CERTIFICATE



OF

Land Survey Monuments situated in Section 21 20, Township 95 North, Range 12 West, of the Fifth Principal Meridian, Chickasaw County, Iowa.  
 Previously recorded in N/A in County Recorder's Office.  
(book, page, document number, etc.)

(Show reason for preparing this certificate, the evidence and detailed procedures used in establishing the corner positions and monumentation found or placed.)  
 Monument Description and Remarks: see below

PLAN - VIEW

(Show a minimum of three reference ties to durable physical objects, relevant monuments and physical conditions that will enable recovery of the corner.)

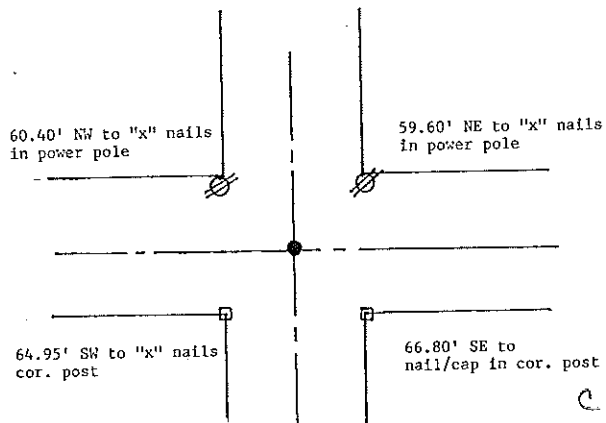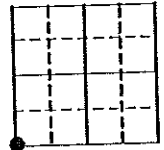

Southwest corner 21-95-12  
 Found 1 1/4" pipe 10" deep

Cor B  
 20-95-12

I hereby certify that the survey work was completed and this certificate was prepared by me or under my direct personal supervision and that I am a duly registered land surveyor under the laws of the state of Iowa.

Signature: Steve Busse  
 Name typed or printed: STEVE BUSSE  
 Date: 11/4/94 Reg. No. 9018

MY REGISTRATION IS SUBJECT TO RENEWAL DEC. 31, 1999.

SEAL

Corners	List Corners to be Indexed		
	Section	Twp	Range
SW cor.	21	95	12

Corner B - 20-95-12