

Section 28-95-12
 As referred to in
 Engg. T. Book

FILED 2004-1886
 RECORDER'S OFFICE
 CHICKASAW COUNTY, IOWA
 2004 AUG 12 AM 9 27
 CINDY MESSERSMITH
 COUNTY RECORDER

TEKIPPE ENGINEERING, P.C., 128 South Vine Street, West Union, Iowa 52175 Phone (563) 422-6131

UNITED STATES PUBLIC LAND SURVEY CORNER CERTIFICATE


Land Survey Monuments situated in Section 28, Township 95 North, Range 12 West of the Fifth Principal Meridian, CHICKASAW County, Iowa.
 Previously recorded in (1) Bk. 154, Pg. 128 (2) none in County Recorder's Office.
 (book, page, document number, etc.)

(Show reason for preparing this certificate, the evidence and detailed procedures used in establishing the corner positions and monumentation found or placed.)

Monument Description and Remarks: (1) NE Corner Section 33 T95N R12W: Found PK nail with information obtained from the previous Section Corner Certificate recorded in the Chickasaw County Recorder's Office in Deeds Book 154, Page 128. The previous monument was covered by a resurfacing of the highway and the monument was reset by Chickasaw County employees. Two reference ties from the previous certificate were missing; two reference ties were added.
 (2) W 1/4 Corner Section 33 T95N R12W: Set 1/2" ϕ rebar w/2" ϕ aluminum cap PLS 16961 at centerline of road on Westerly extension of possession line fence.

PLAN - VIEW

(Show a minimum of three reference ties to durable physical objects, relevant monuments and physical conditions that will enable recovery of the corner.)

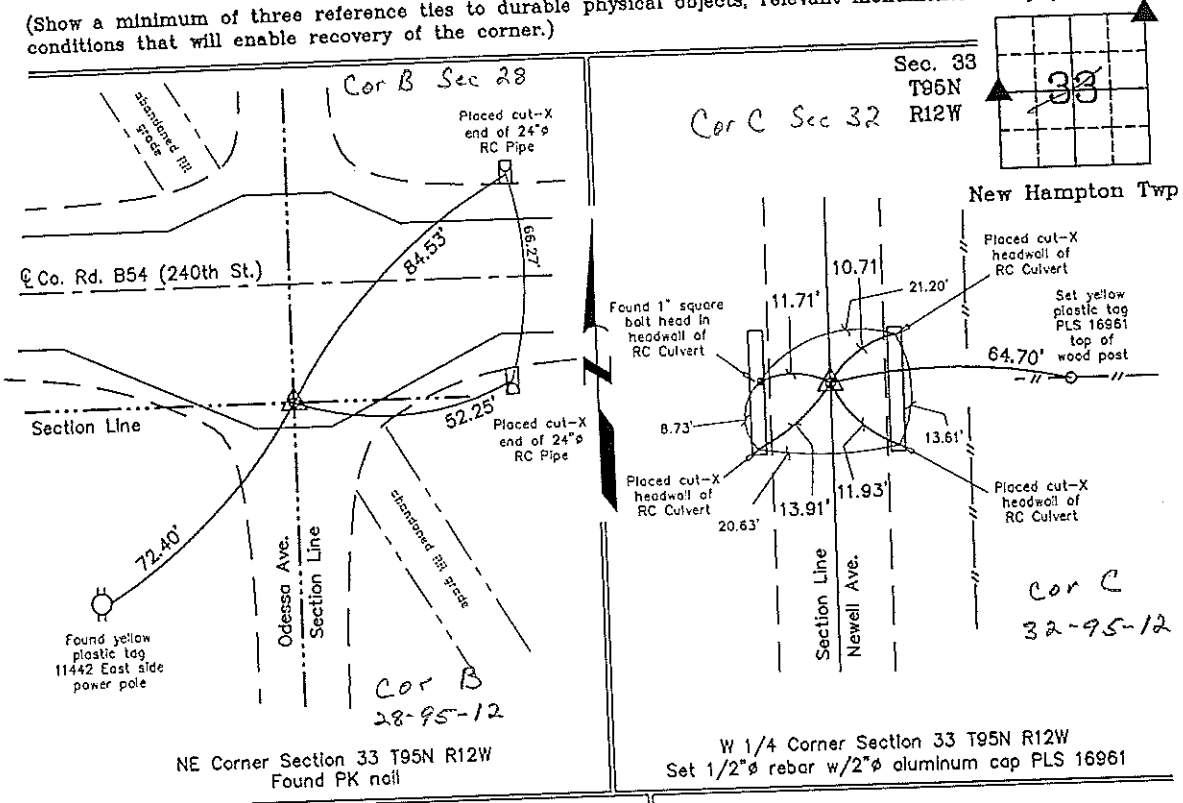

I hereby certify that this land surveying document was prepared and the related survey work was performed by me or under my direct personal supervision and that I am a duly licensed Land Surveyor under the laws of the State of Iowa.
 Michael J. Shimak August 11, 2004
 Michael J. Shimak Date
 License number 16961
 My license renewal date is December 31, 2005.
 Sheets covered by this seal: Individual

List Corners to be Indexed			
Corners	Section	Twp.	Range
NE	33	95N	12W
W 1/4	33	95N	12W

X:\Section Corners\Sec. 33\33-95-12ek.dwg
 Project Number 04168.LS
 FB. 45K PG. 01-00